


# T. 7 S. R. 1 W. W. M.

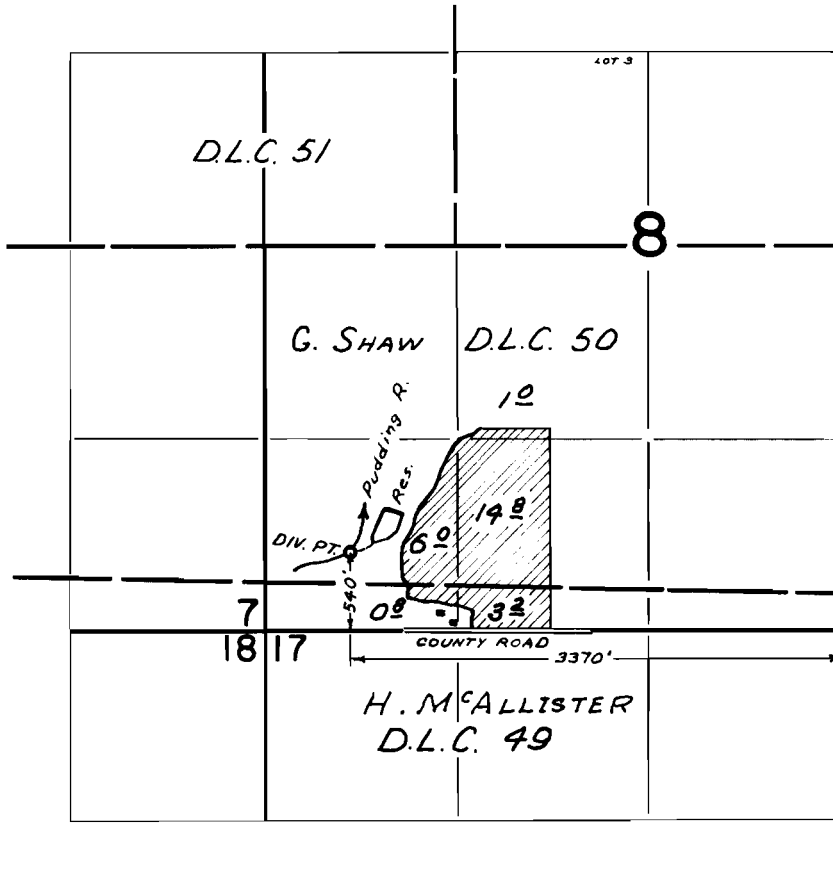

## FINAL PROOF SURVEY UNDER

Application No. <sup>R-33213</sup> 33214 Permit No. <sup>R-2259</sup> 26259

IN NAME OF

Ben Kaufman

Surveyed <sup>APR 1</sup> 1956, by <sup>M. BISH</sup>  
<sup>JUL 1</sup> 1963 <sup>T. LAUER</sup>