


T. 7 S. R. 1 W. W. M.

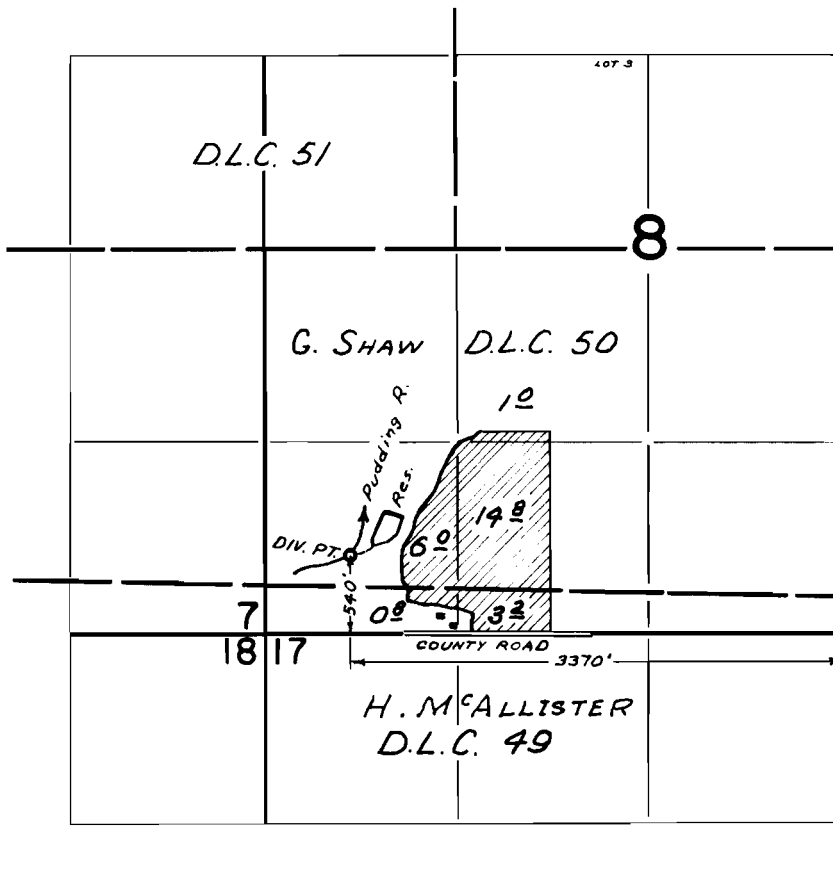

FINAL PROOF SURVEY UNDER

Application No. ^{R-33213} 33214 Permit No. ^{R-2259} 26259

IN NAME OF

Ben Kaufman

Surveyed ^{APR 1} 1956, by ^{M. BISH}
^{JUL 1} 1963 ^{T. LAUER}