


T.14 S.R.1 W.W.M

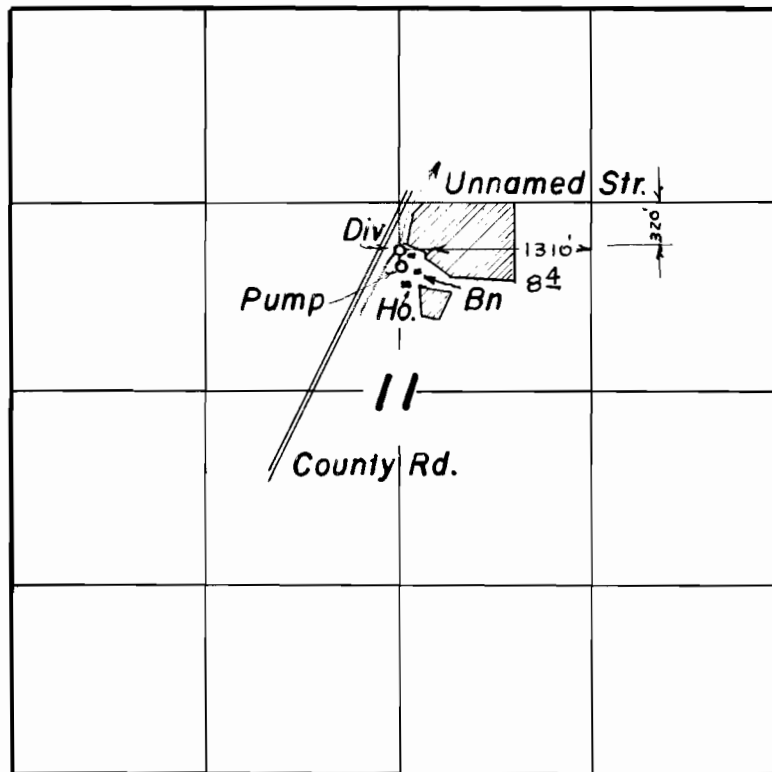

FINAL PROOF SURVEY
UNDER

Application No. 34600 Permit No. 27168
IN NAME OF

Raymond R. & Mildred Michaelis

Surveyed June 12 1965, by F. Siegmund