


T.11S.R.5W.W.M.

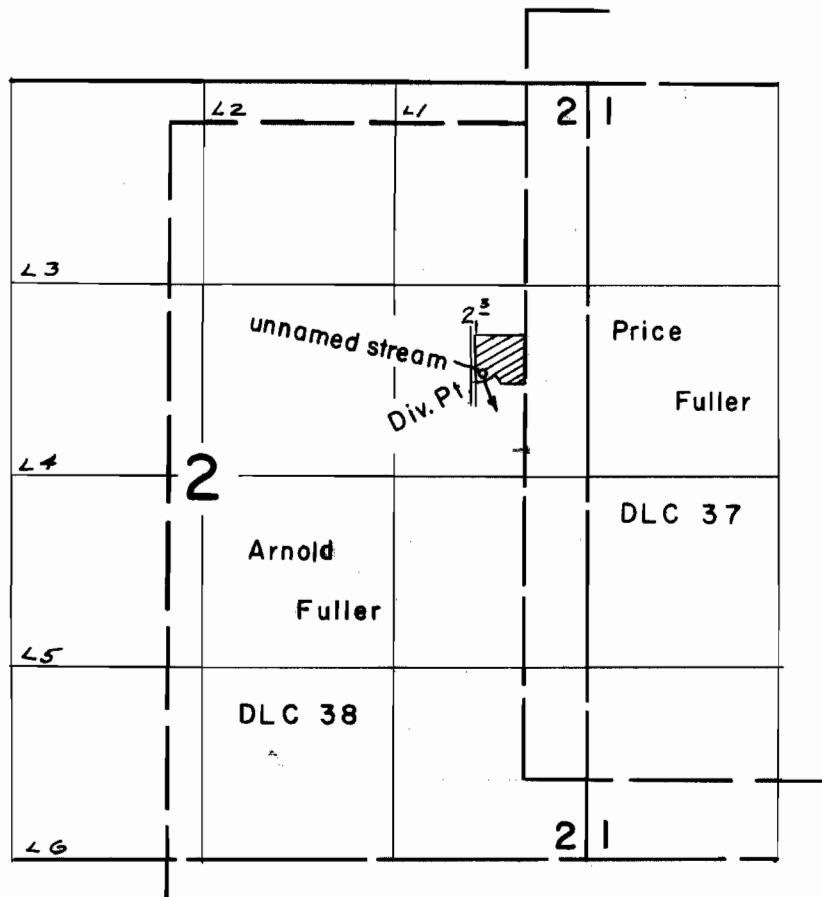

FINAL PROOF SURVEY
UNDER

Application No. 33700 Permit No. 26636
IN NAME OF

Monroe T. Cline

Surveyed July 20, 1964, by F. Siegmund