


T.6S. R.IE. W.M.

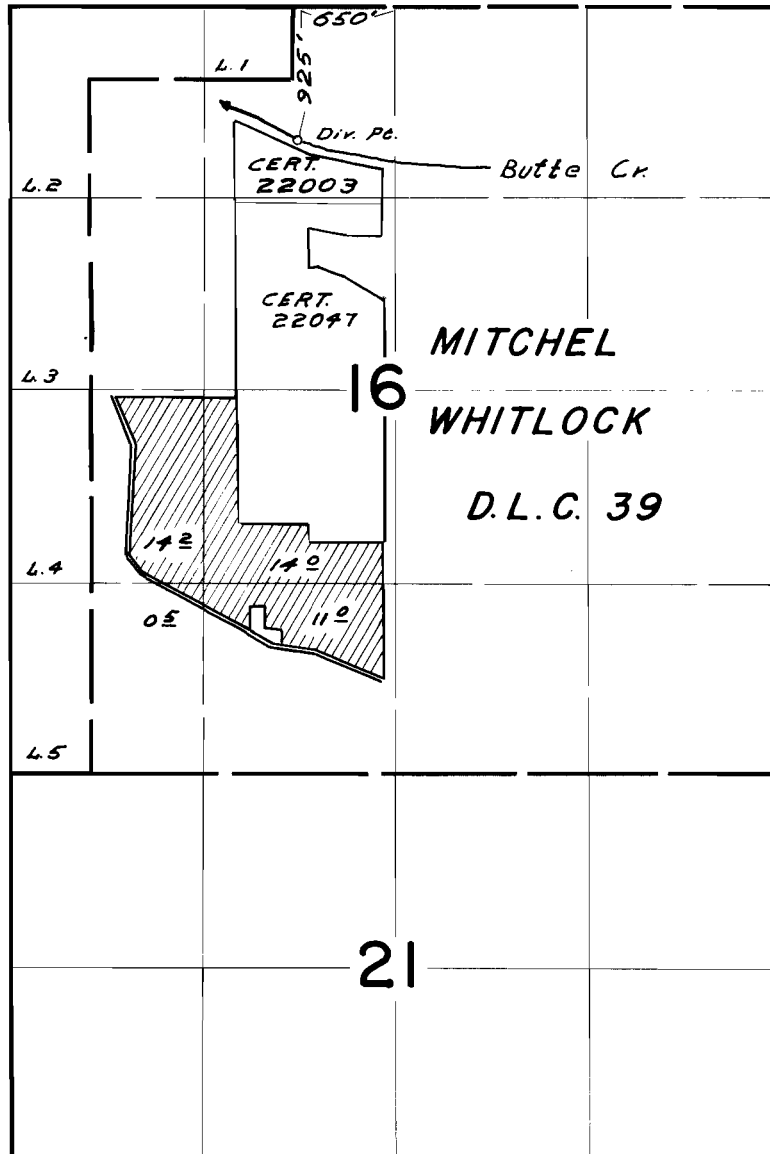

FINAL PROOF SURVEY UNDER

Application No. 35089 Permit No. 27454
IN NAME OF

ALOIS IMPER

Surveyed JUNE 15 1965, by L. COLEBANK