


T.18 S. R. 46 E. W.M.

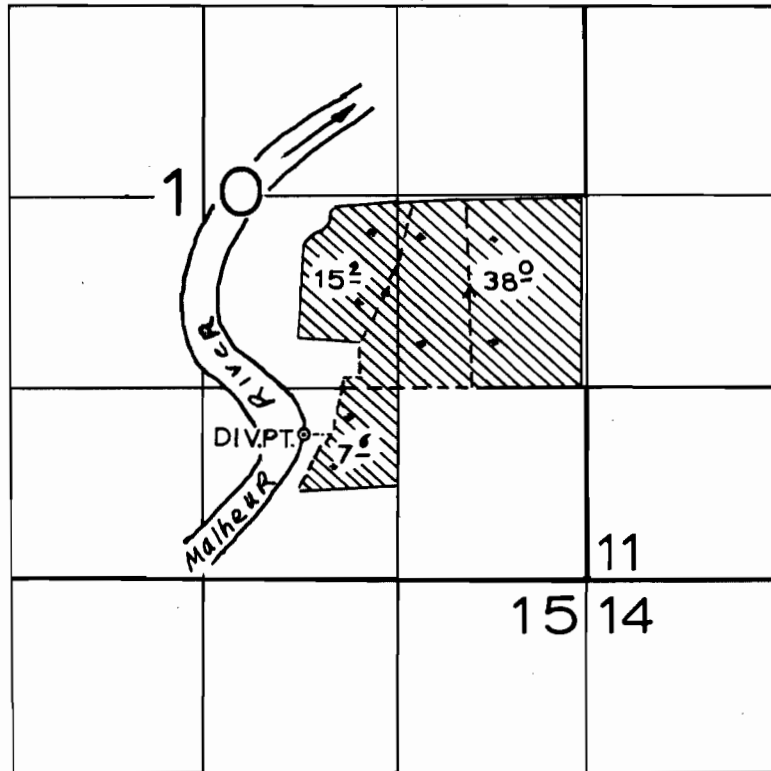

FINAL PROOF SURVEY
UNDER

Application No. 34977..... Permit No. 27697.....
IN NAME OF

WESLEY AND GERTRUDE BLANTON

Surveyed APRIL 15, 1965., by *F.W. Blanton*