


T. 9S., R. 3W., W.M.

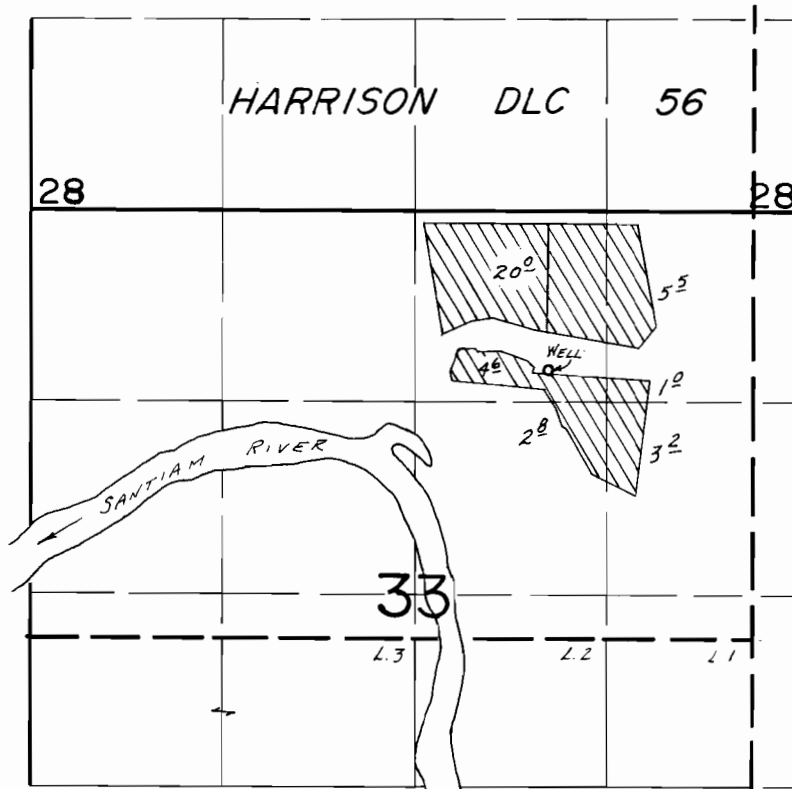

WELL LOC.: 1850' N. & 1400' W. FROM SE COR. HARRISON DLC 56.

SCALE: 1" = 1320'

**FINAL PROOF SURVEY**  
UNDER

Application No. G-2651... Permit No. G-2486...  
IN NAME OF

.....ELMER L. COOK.....

Surveyed Sept. 22... 19.65., by F. SIEGMUND.....