


T.13 S.R. 6 W.W.M.

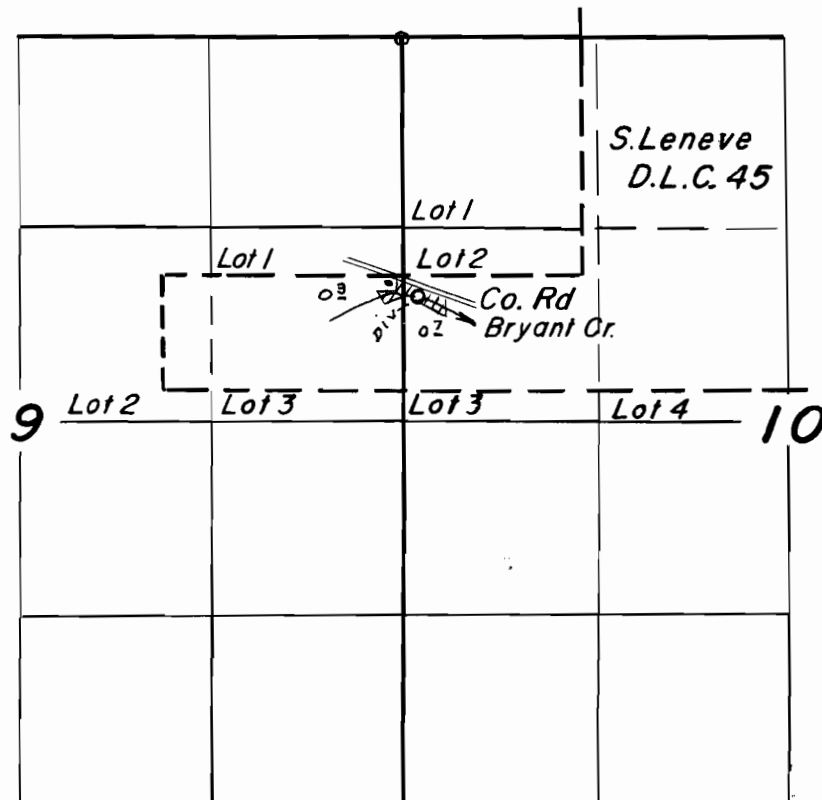

FINAL PROOF SURVEY
UNDER

Application No. *35035* Permit No. *27439*
IN NAME OF

C.D. Vaughn

Surveyed *July 24 1964*, by *F. Siegmund*