


T.9 S.R.3 E.W.M.

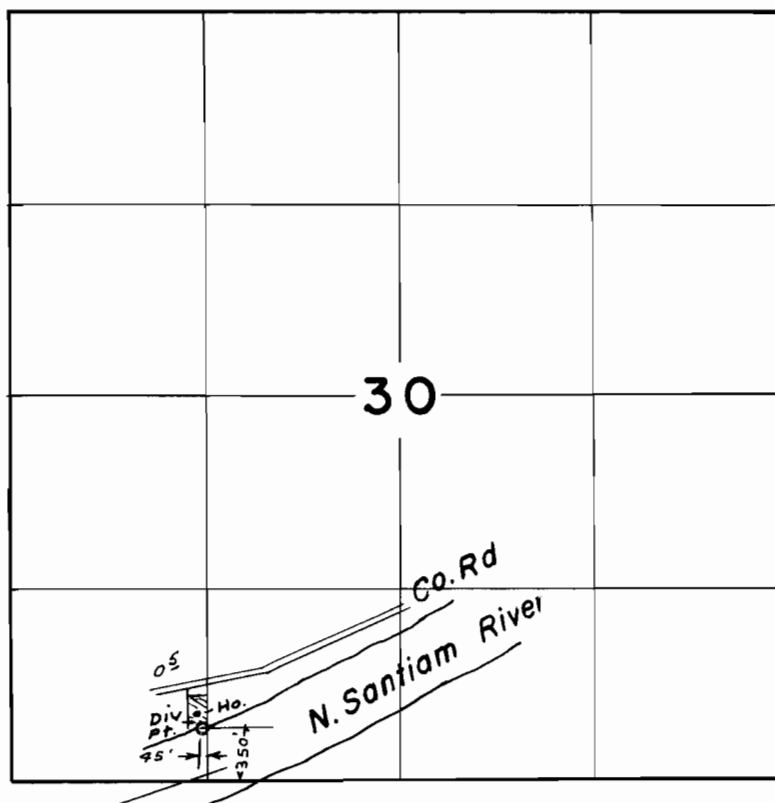

**FINAL PROOF SURVEY**  
UNDER

Application No. 37722 Permit No. 28121  
IN NAME OF

**Lee S. Ross**

Surveyed June 17 1965, by F. Siegmund