


T. 17S. R. 3E. W.M.

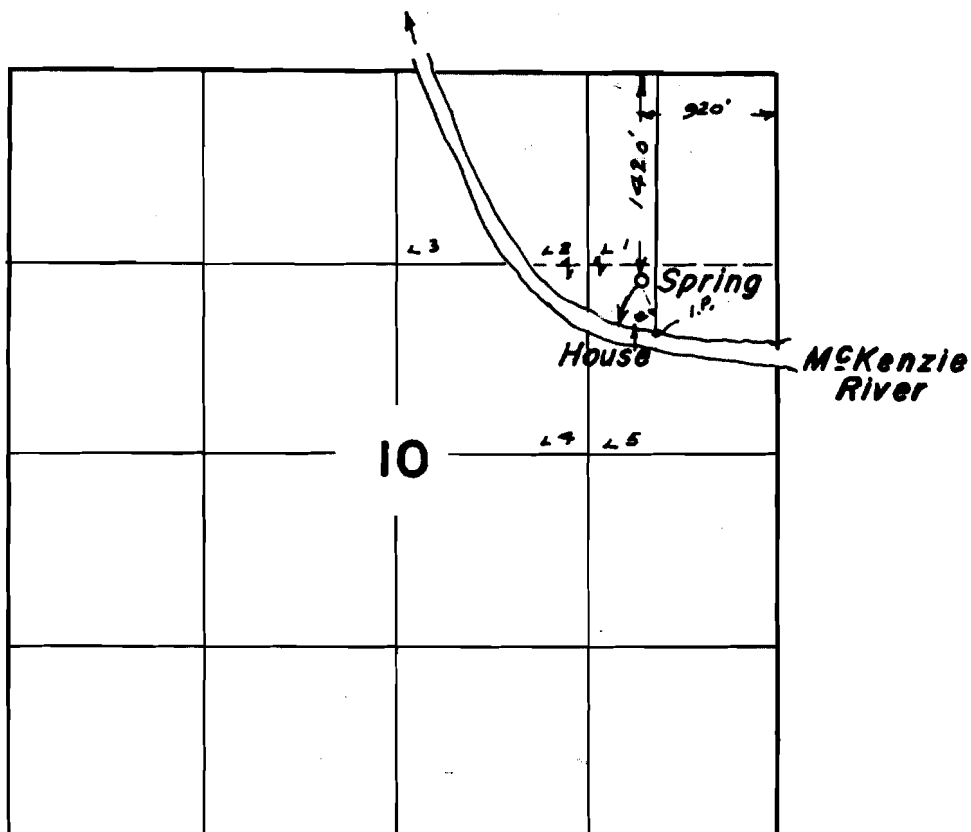

FINAL PROOF SURVEY
UNDER

Application No. 39933 Permit No. 29722
IN NAME OF

Adolph W. & Evelyn R. Siegrist

Surveyed June 14 1965, by F. Siegmund