


T. 35 S. R. 18 & 2. W. W. M.

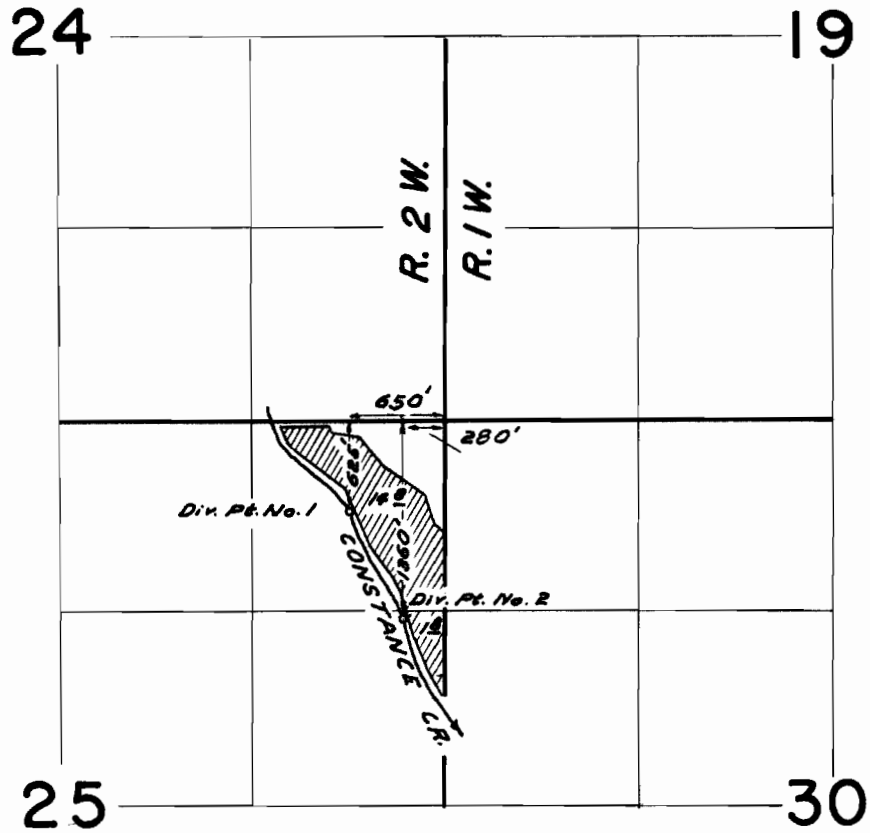


**FINAL PROOF SURVEY**  
UNDER

Application No. 26614 Permit No. 22885  
IN NAME OF

CLAYTON CHARLEY

Surveyed JULY 17, 1965, by L. COLEBANK

T. 35 S. R. 1 W. W. M.

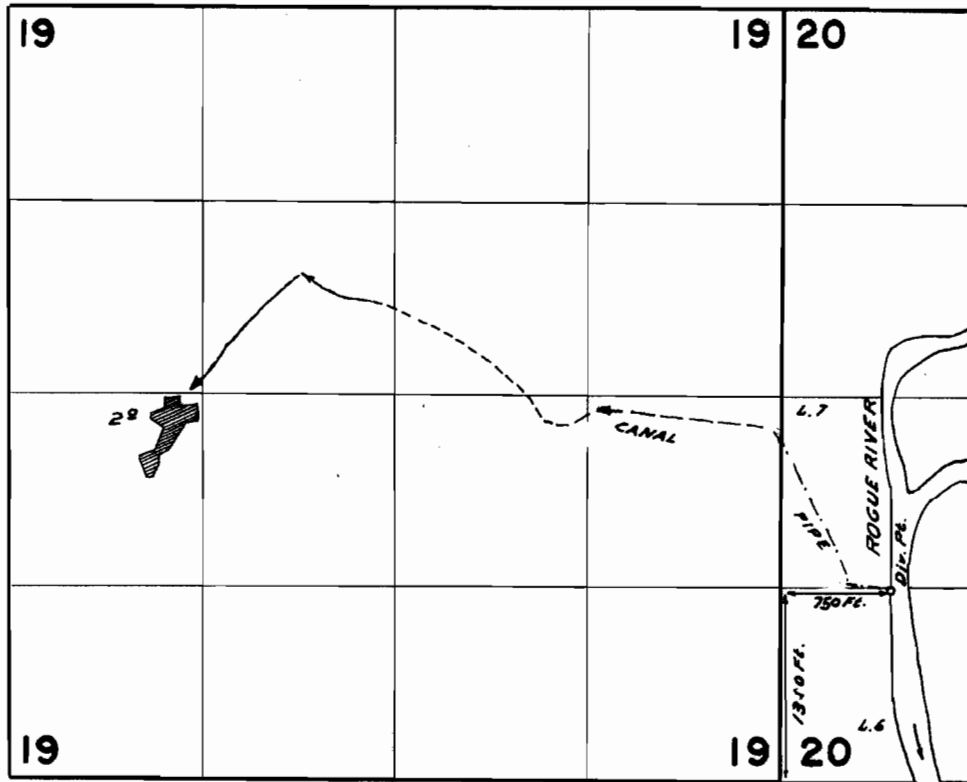

**FINAL PROOF SURVEY**  
UNDER

Application No. 26614 Permit No. 22885  
IN NAME OF

DAN F HAAS

Surveyed JULY 17 1965, by L. COLEBANK