


T. 10 S. R. 6 E. W. M.

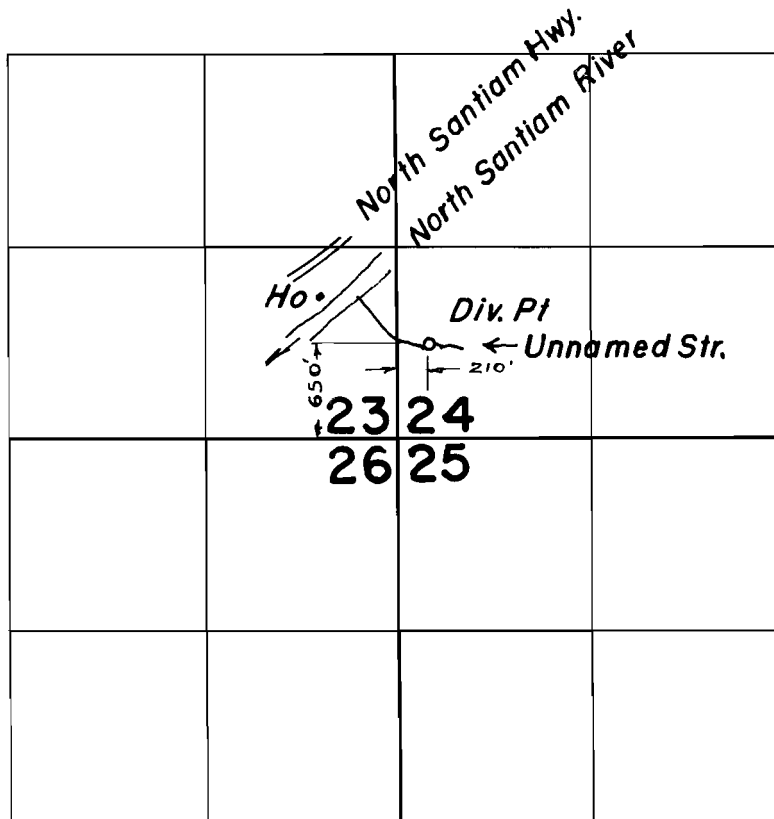

FINAL PROOF SURVEY
UNDER

Application No. 39796 Permit No. 29581
IN NAME OF

Ivan Blodgett

Surveyed June 28 1965, by F. Siegmund