
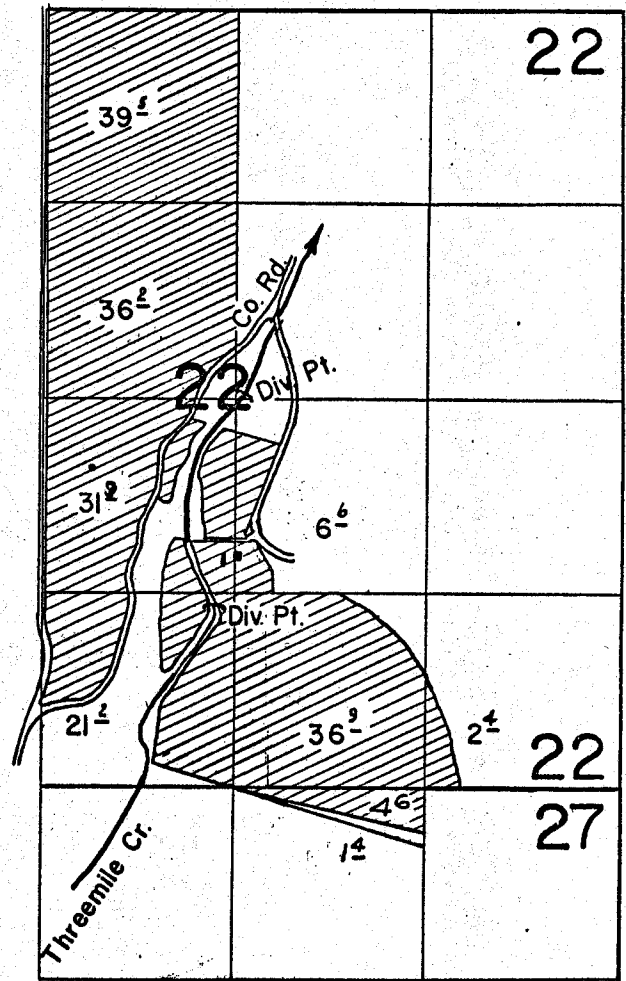


T. 1 N. R. 13 E. W. M.

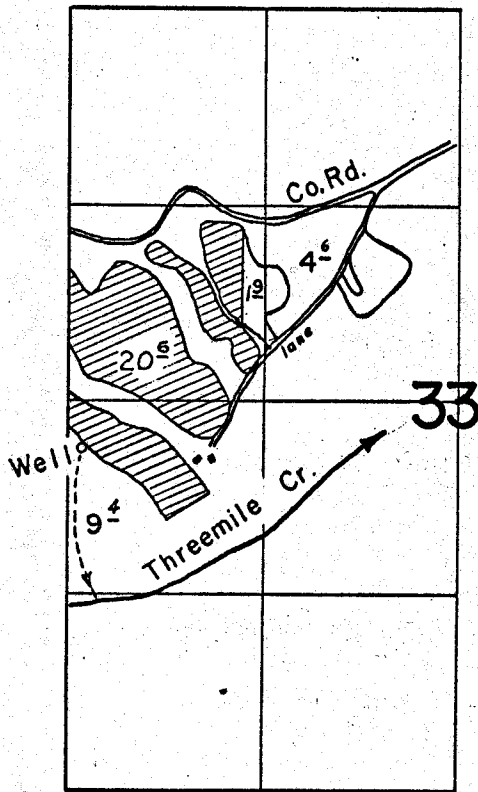

FINAL PROOF SURVEY UNDER

Application No. G-1600... Permit No. G-1466...
IN NAME OF

ROBERT E. & ARTHUR E. SANDERS

Surveyed April 8, 1963, by *Larry J. Bousch*