


T.35S.R.2 W.W.M.

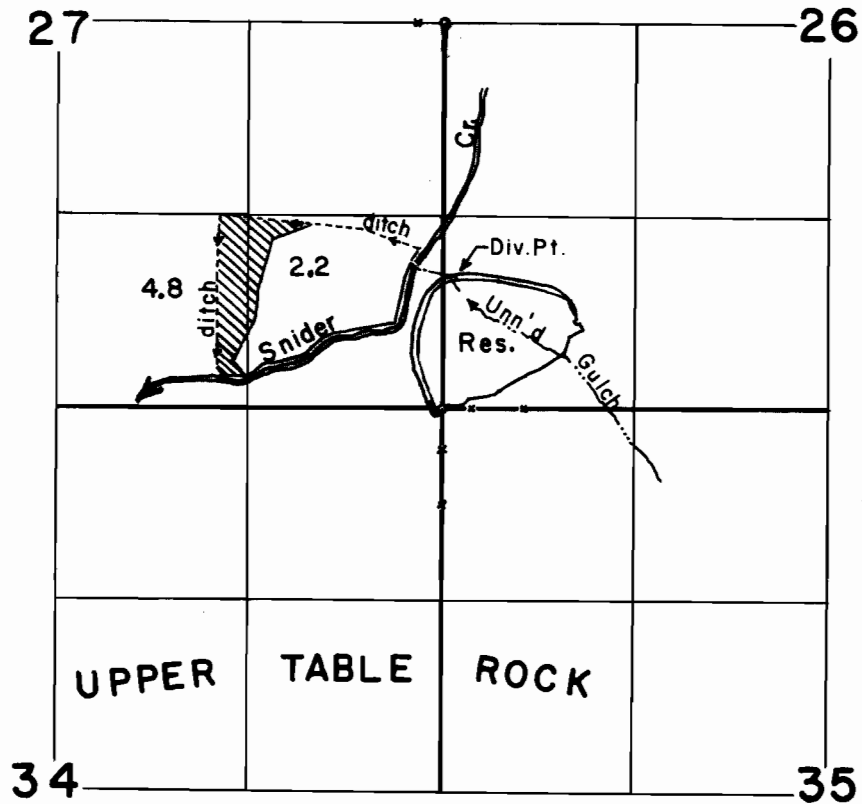

FINAL PROOF SURVEY UNDER

Application No. 34638... Permit No. 27208...
IN NAME OF

..... Werner J. & Patricia A. Donat

Surveyed June 14, 1966, by D.C. Hendrix