


T. 1 S. R. 2 W. W. M

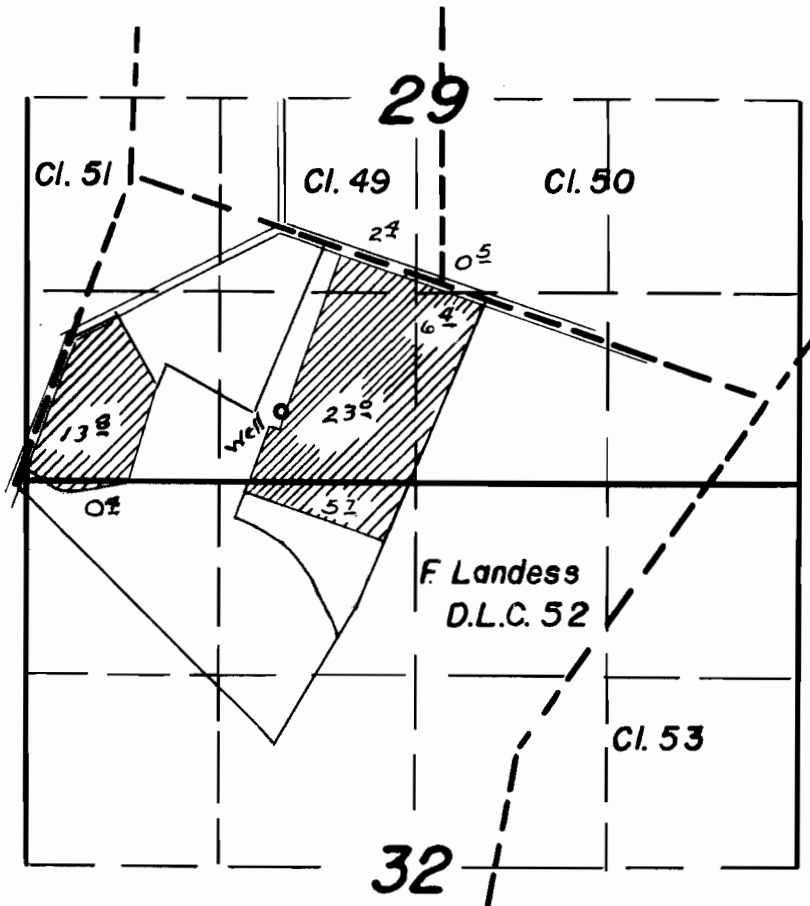

FINAL PROOF SURVEY
UNDER

Application No. *G. 2312* Permit No. *G. 2138*
IN NAME OF

Walter Schallberger Jr.

Surveyed *Mar. 30* 1963, by *M. Bish*