


T.8S.,R39E.W.M.

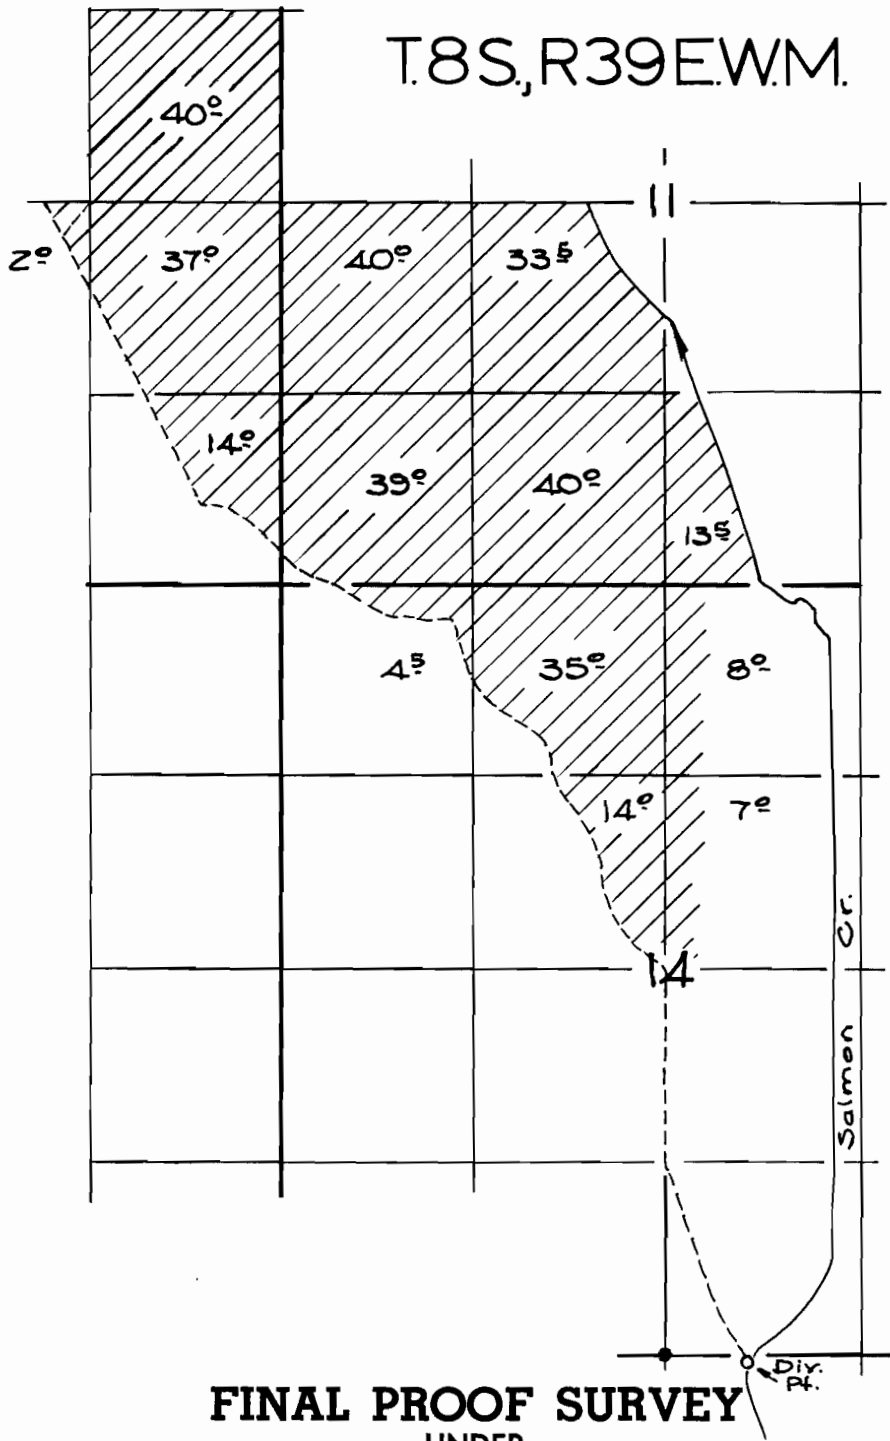

**FINAL PROOF SURVEY**  
UNDER

Application No. 28656 Permit No. 22632  
IN NAME OF

JOHN A. PAYTON et al

Surveyed Nov. 9, 1965, by D.B. Hall