


T. 7 S. R. 10 & 11 W. W. M.

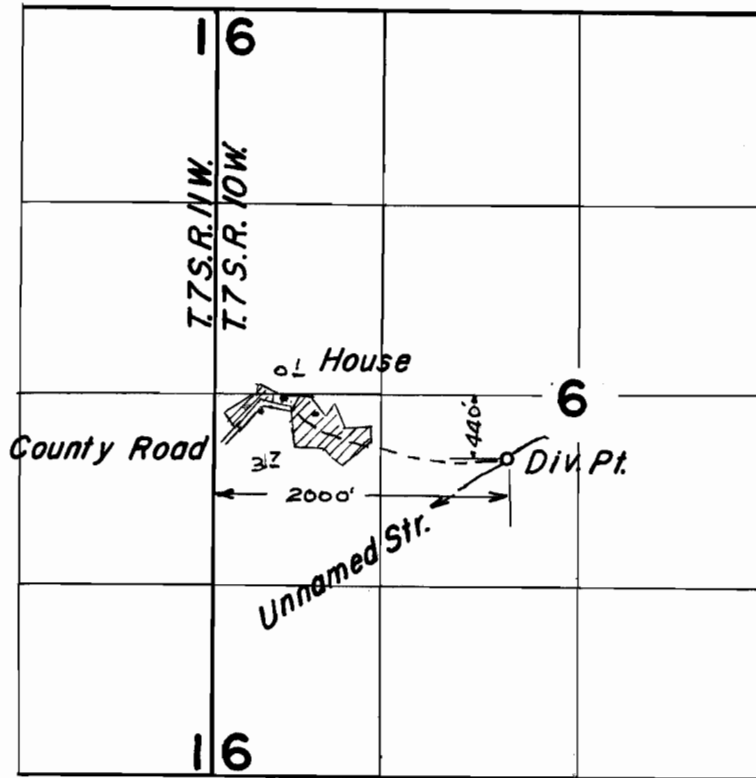

**FINAL PROOF SURVEY**  
UNDER

Application No. 33971 Permit No. 26778  
IN NAME OF

W.C. & R.L. Kivett

Surveyed Oct. 14, 1965, by F. Siegmund