


T. 7 S. R. 1 W. W. M.

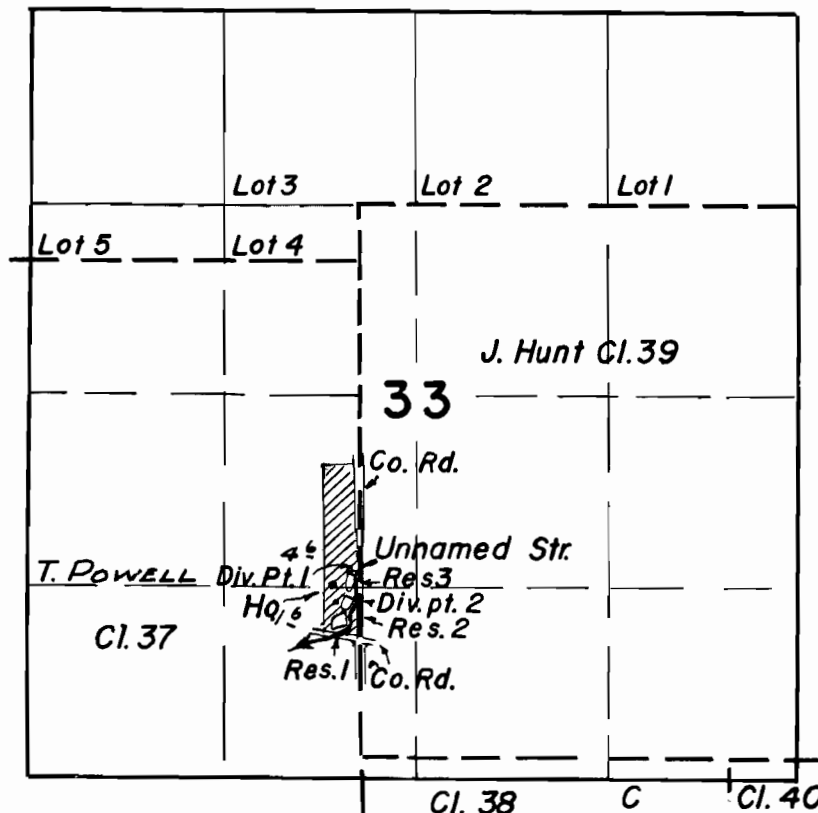

Div. 1 2530' S. and 50' West of N.W. Cor. of J. Hunt D.L.C. No. 39
Div. 2 2710' S. and 40' West of N.W. Cor. of J. Hunt D.L.C. No. 39

FINAL PROOF SURVEY
UNDER

Application No. ³⁸⁷⁶⁴~~R-38763~~ Permit No. ²⁸⁷⁸⁸~~R-3256~~
IN NAME OF

Paul Laden

Surveyed *Sept. 20* 1965, by *F. Siegmund*