


T.3S.R.5E.W.M.

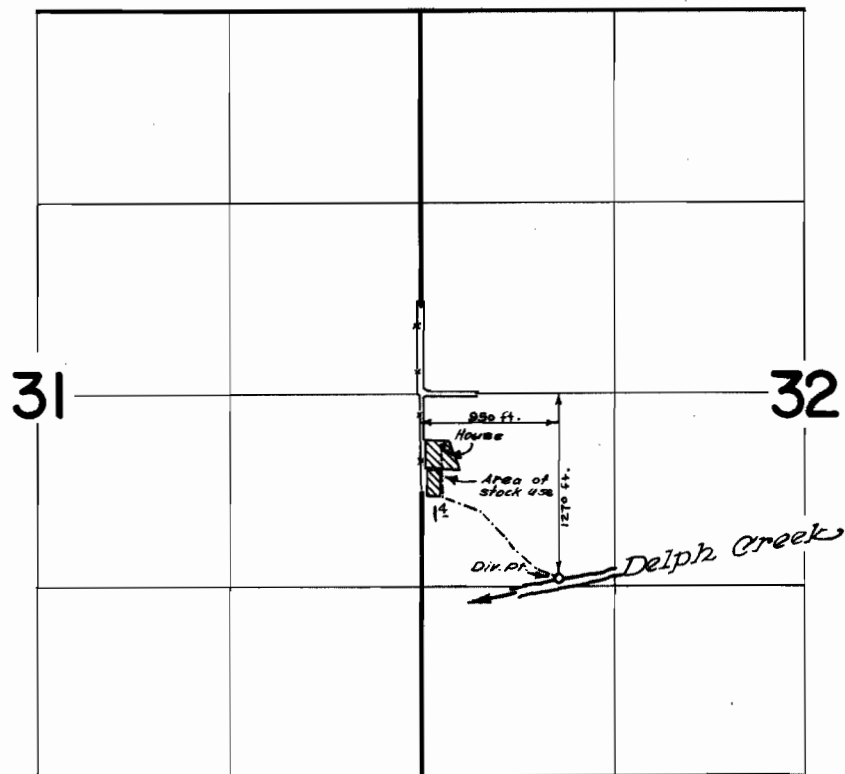

FINAL PROOF SURVEY
UNDER

Application No. 38542... Permit No. 28724...
IN NAME OF

OLIVER DONALD BOWMAN

Surveyed April 22, 1965, by *R. Jackson*