


T. 14 S. R. 1 E. W. M.

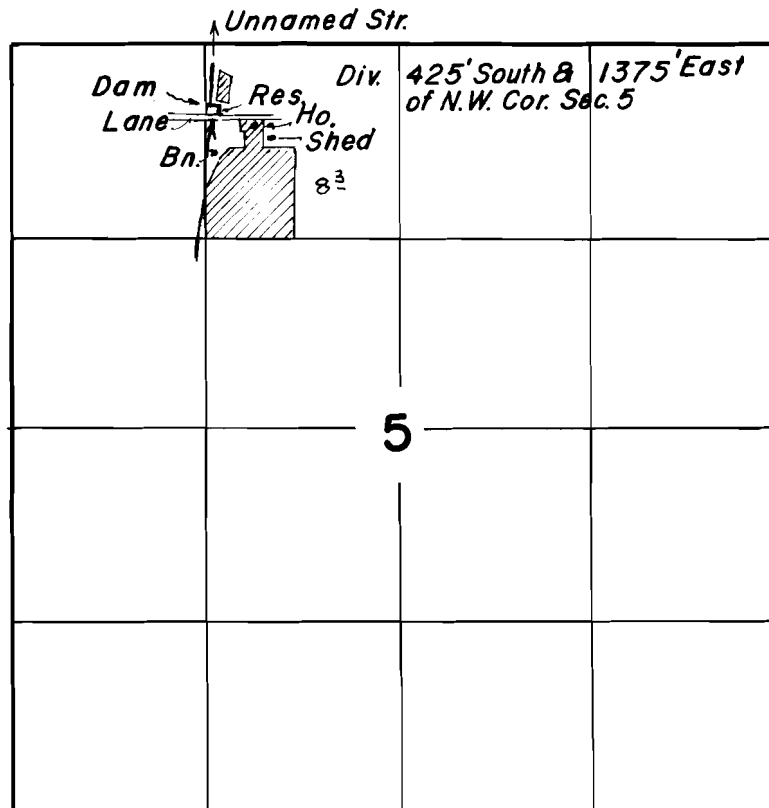

FINAL PROOF SURVEY
UNDER

R-33763 *R 2338*
Application No. *33764* Permit No. *26658*
IN NAME OF

Lela & Charlie Walker

Surveyed *June 7, 1965*, by *F. Siegmund*