


T.9S.R.4E.W.M.

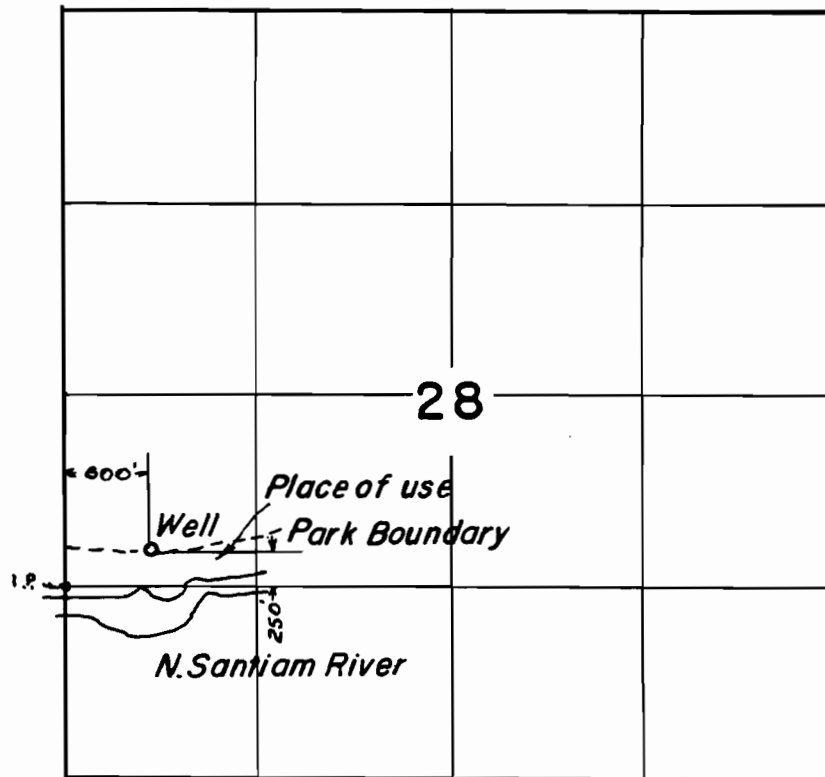

FINAL PROOF SURVEY
UNDER

Application No. G-2416 Permit No. G-2218
IN NAME OF

Marion County Park & Recreation Comission

Surveyed June 10, 1965, by F. Siegmund