


T.9 S.R. I W.W.M.

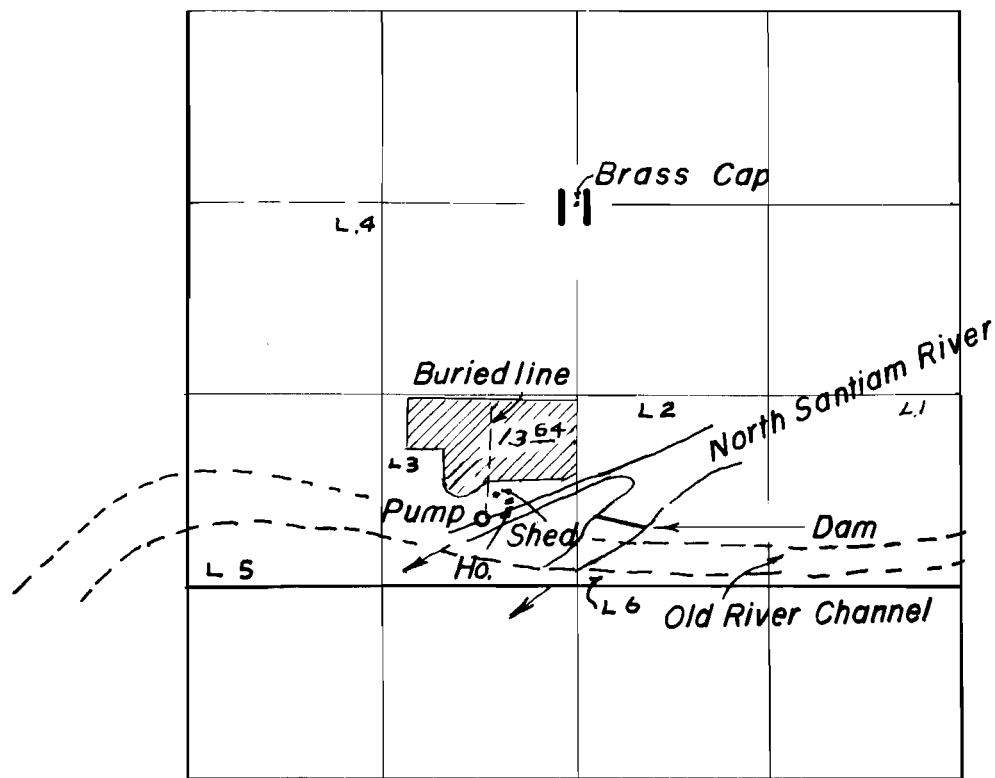

FINAL PROOF SURVEY
UNDER

Application No. 37697 Permit No. 28089
IN NAME OF

George W. Wallace

Surveyed Aug. 23 1965, by F. Siegmund