


T. 4N. R. 3W. W.M.

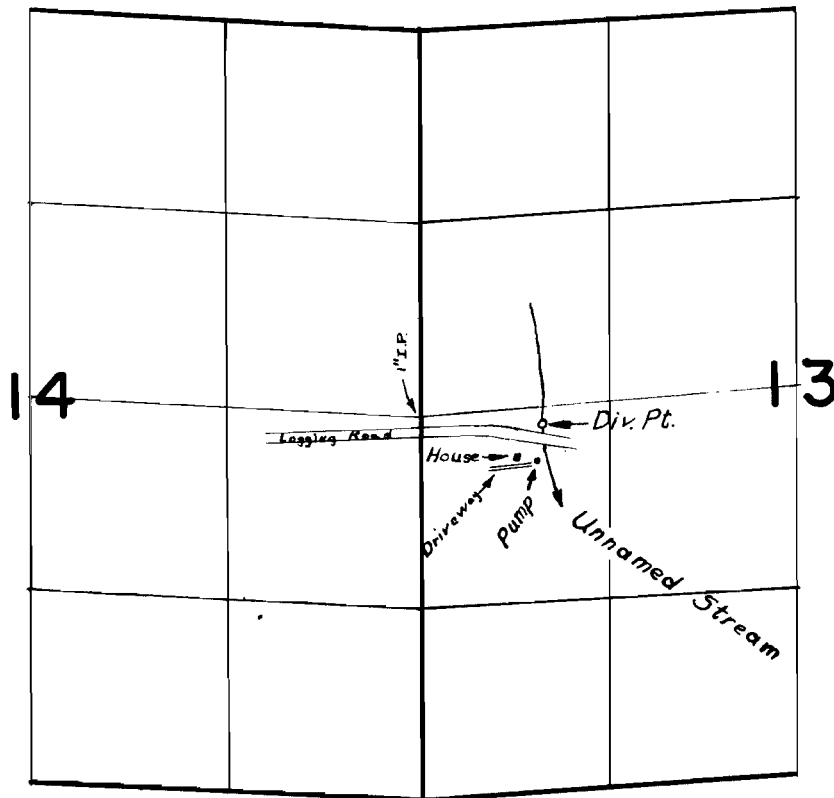

FINAL PROOF SURVEY
UNDER

Application No. 37575 Permit No. 27993
IN NAME OF

ERNEST W. LIDEN

Surveyed Oct. 5 1964, by M. Bish

1964-18

S. S. J.