


# T.40 S. R.3W.W.M.

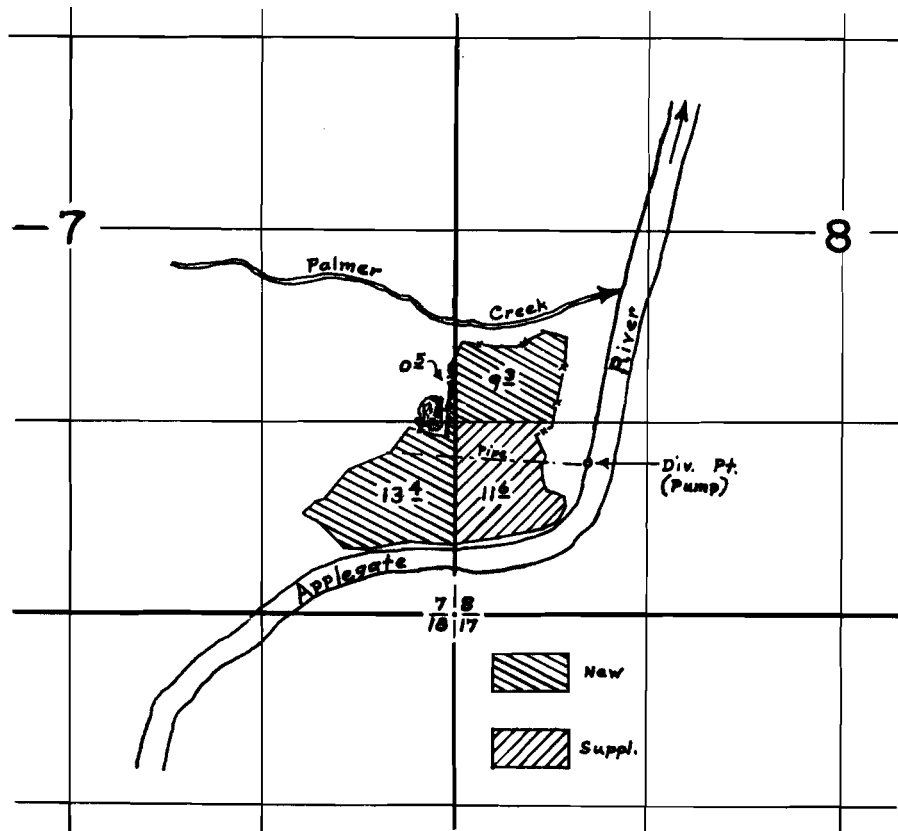

## FINAL PROOF SURVEY UNDER

Application No. 30228 Permit No. 23830  
IN NAME OF

RALPH & MARIAN K. STAYER

Surveyed May 23 1963, by CBaker