


T. 11 S. R. 3 W. W. M.

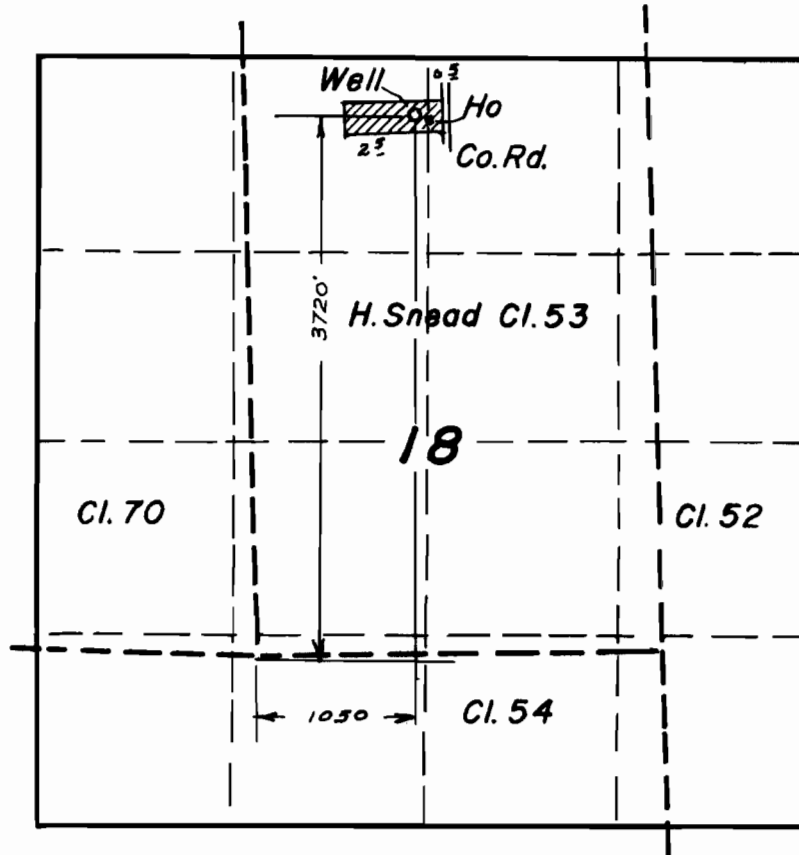

**FINAL PROOF SURVEY**  
UNDER

Application No. *G 2181* Permit No. *G-2011*  
IN NAME OF

***Edwin P. & Mary E. Savard***

Surveyed *July 1* 1965, by *F. Slegmund*