


T.15 S. R. 42 E. W.M.

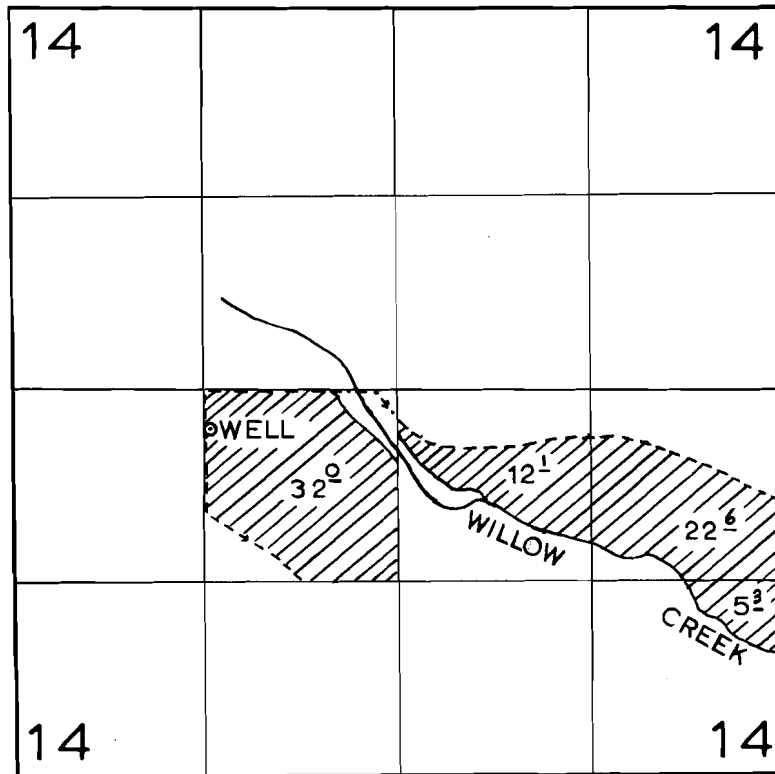

**FINAL PROOF SURVEY**  
UNDER

Application No. G-2060 Permit No. G-1888  
IN NAME OF

F. A. PUGH

Surveyed NOV. 16, 1964, by F. W. Elfring