


T. 26 S. R. 3 W. W.M.

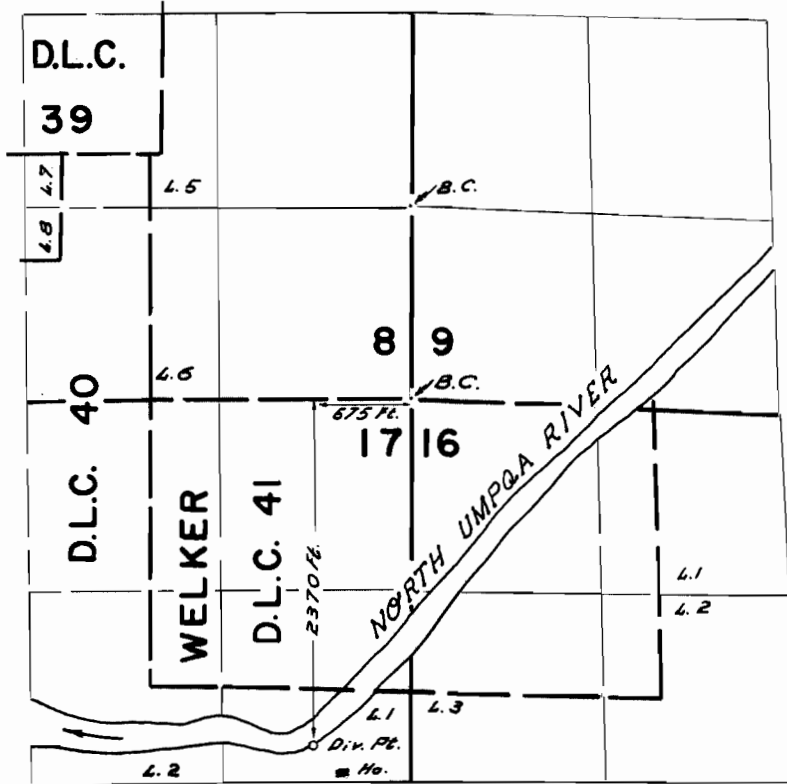

FINAL PROOF SURVEY
UNDER

Application No. 39883 Permit No. 29693
IN NAME OF

D L PARKER

Surveyed OCT. 27 1965, by L. COLEBANK