


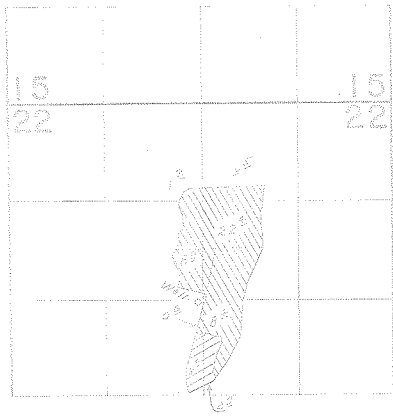

G-2412

G 2412

3376

T.13S. R.29E. W.M.



 Supplemental  
 Primary

FINAL PROOF SURVEY  
UNDER

Application No. G-2547.. Permit No. G-2412  
IN NAME OF

CURTIS MARTIN

Surveyed Oct. 24, 1968., by B. Jackson