


G-2356

G 2356

33367

T13S. R. 29E. W.M.

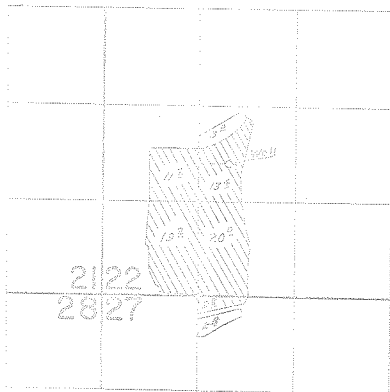

No Prior right on unshaded area.

FINAL PROOF SURVEY
UNDER

Application No. G-2348 Permit No. G-2356.
IN NAME OF

CURTICE MARTIN

Surveyed Oct. 29, 1964, by S. Jackson.....

1284-0