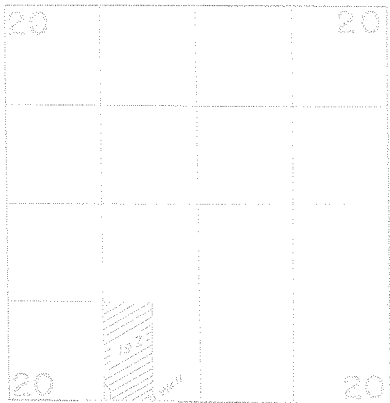


T6N.R33E.WM.

FINAL PROOF SURVEY  
UNDERApplication No. 6-2241, Permit No. 6-2063  
IN NAME OF

DAVID I. ALEXANDER

Surveyed April 18, 1954, by D. V. 0528900