


G 1388
G 185
33369

T.30S.R.16E.W.M.

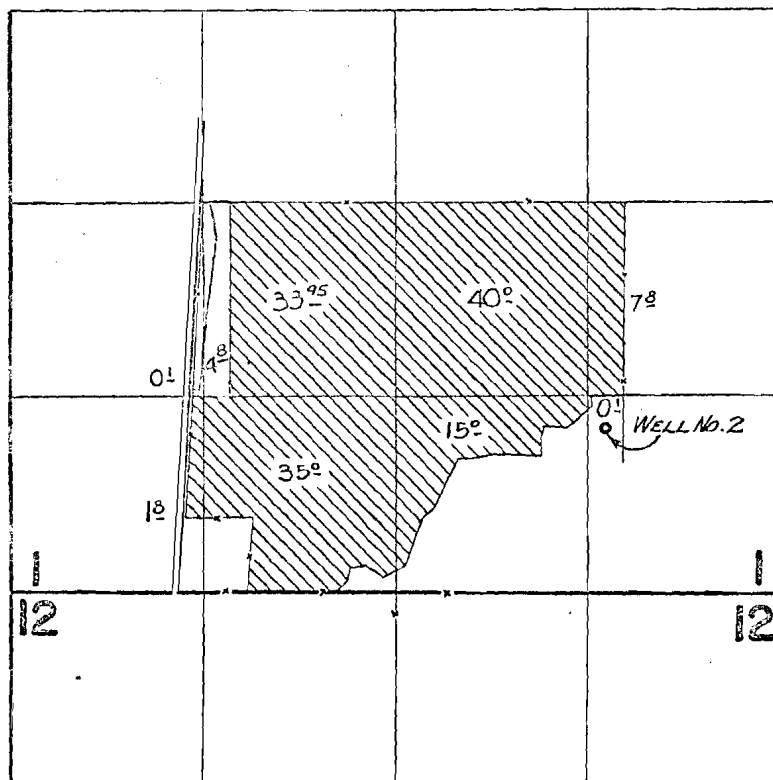

FINAL PROOF SURVEY
UNDER

G-72 G-1388
Application No. G-1987. Permit No. G-1851.
IN NAME OF

Vancil A. Withers - Withers Ranch, Inc.

Surveyed Sept. 18 1964, by *A. Jackson*