


T.20&21S.R.22E. W.M.

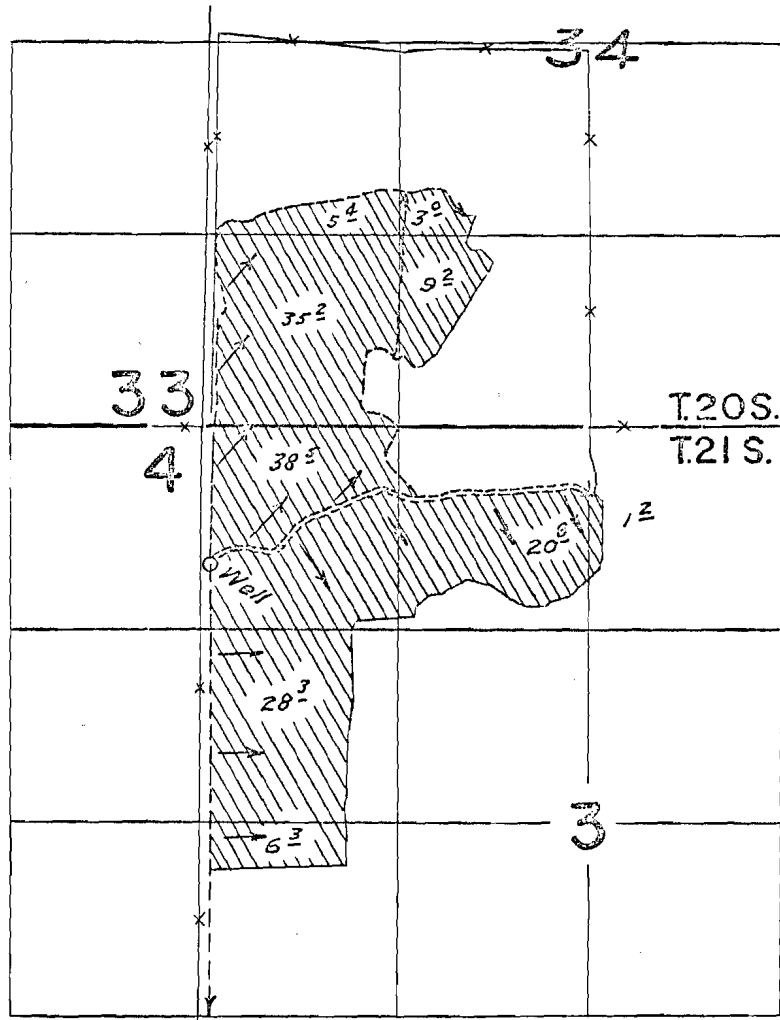

FINAL PROOF SURVEY UNDER

Application No. G-1440. Permit No. G-1305...
 IN NAME OF
LELCO INC.

Surveyed Oct. 8, 1964., by R. Jackson.....

G-1305
 1964-F
 CJG