




T.17S. R.21E. W.M.

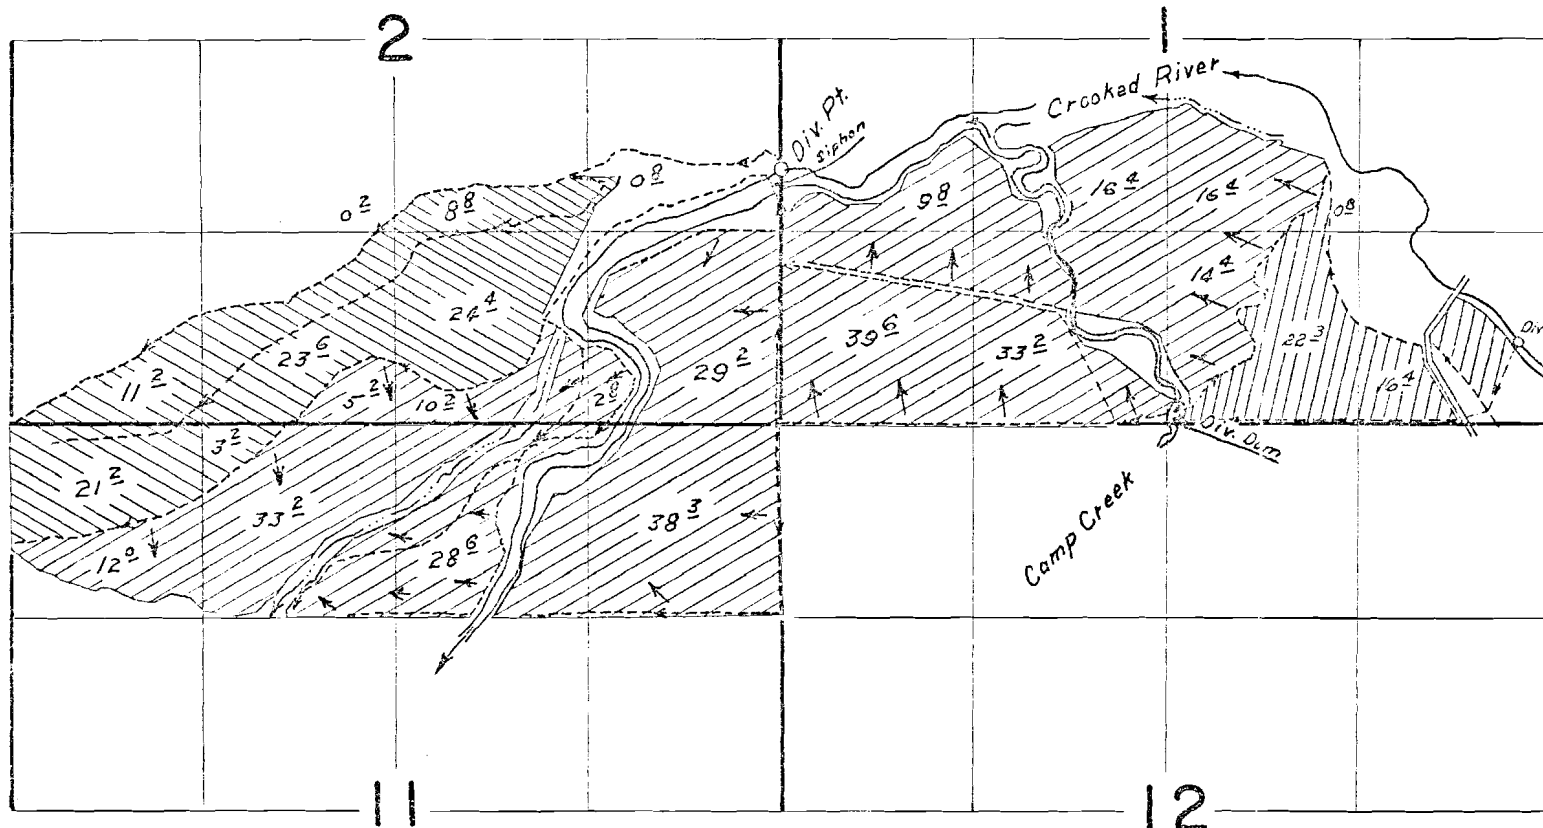

Permit No. 26390

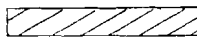

Permit No. 22142

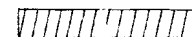

Permit No. 35497

# FINAL PROOF SURVEY

UNDER

Application Nos. 47742, 28130, 33409      35497, Permit Nos. 22142, 26390

IN NAME OF

GALE MERWIN

Aug. 4, 1977      D. NORBY  
Surveyed Sept. 29, 30, 1964      By: R. Jackson

C 23315  
1 10043

26390

1964-F; 1975-B

26390