


T.17S. R.21E. W.M.

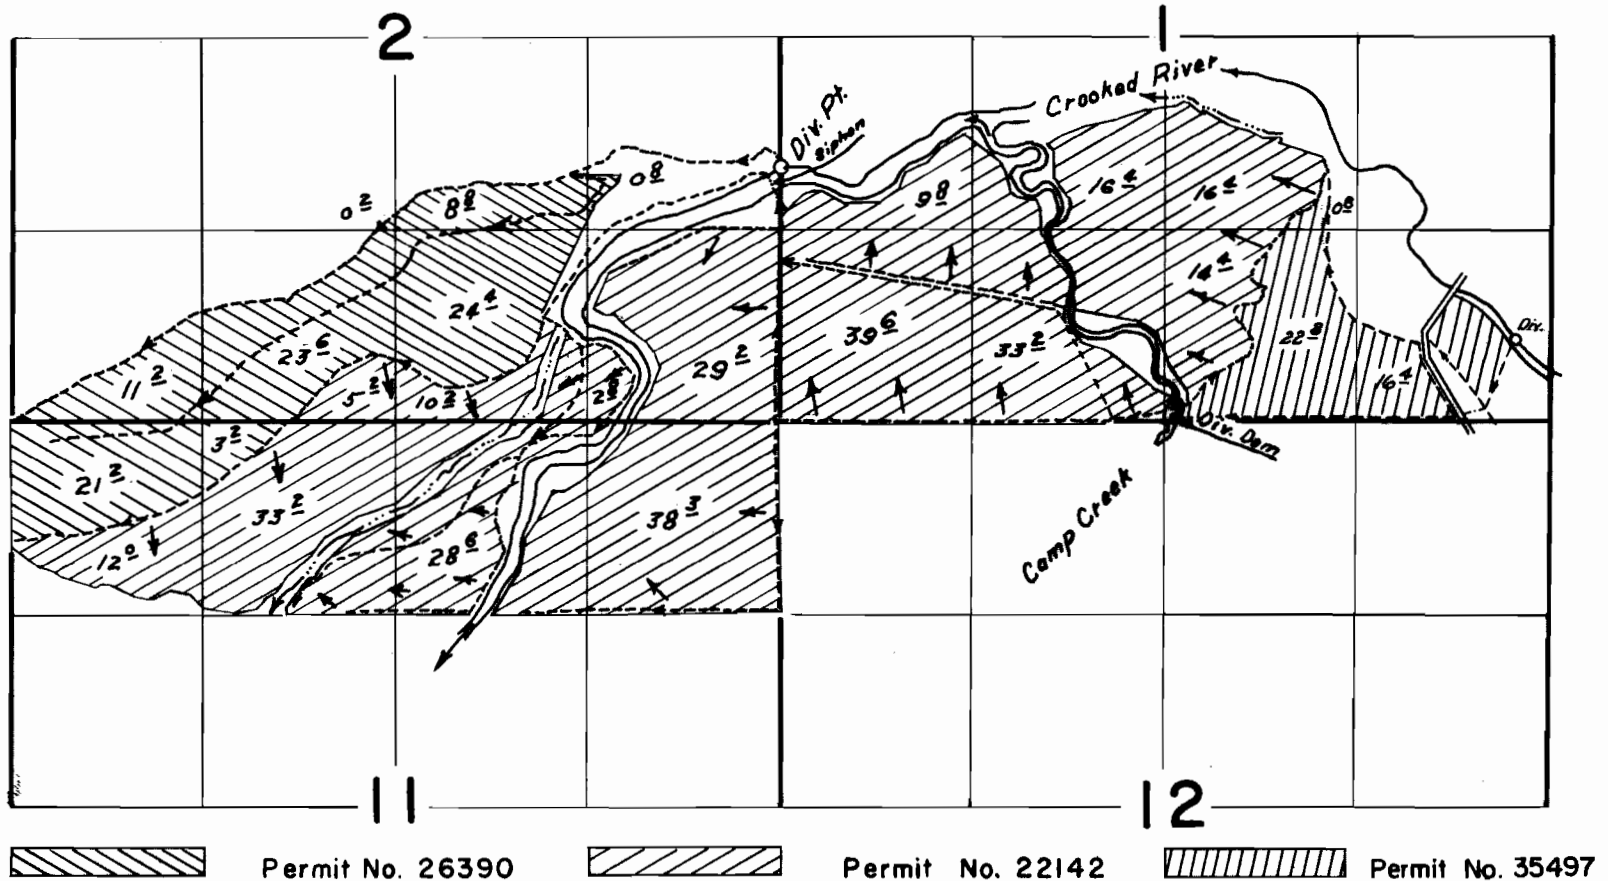

Permit No. 26390      Permit No. 22142      Permit No. 35497

**FINAL PROOF SURVEY**  
UNDER  
Application Nos. 47742, 28130, 33409      Permit Nos. 35497, 22142, 26390  
IN NAME OF  
**GALE MERWIN**  
Aug. 4, 1977      D. NORBY  
Surveyed Sept. 29, 30, 1964      By: R. Jackson