


T.6N.R.35E.W.M.

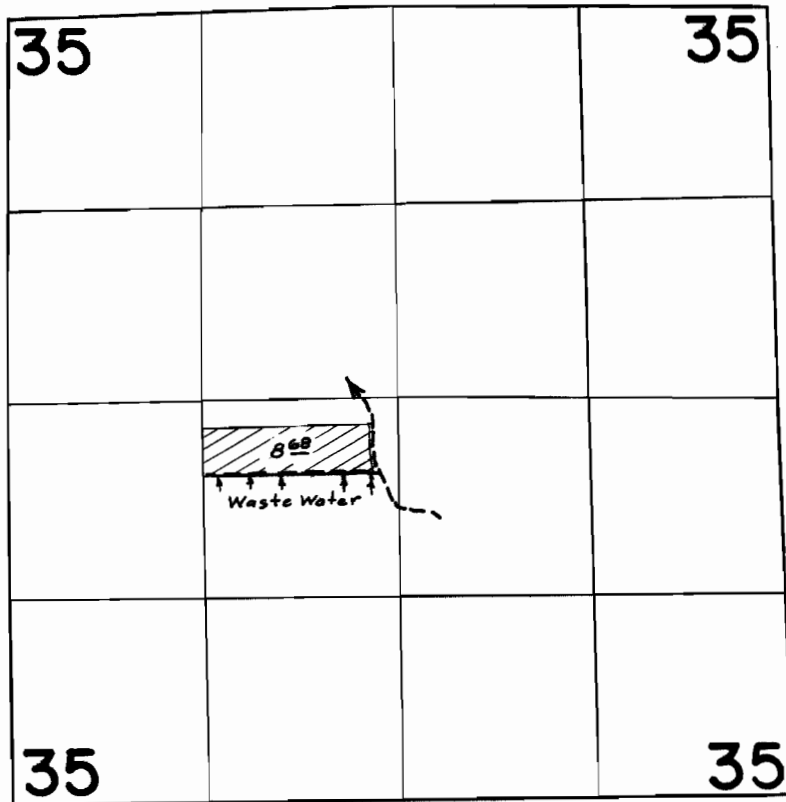

**FINAL PROOF SURVEY**  
UNDER

Application No. 37585... Permit No. 28001...  
IN NAME OF

**HENRY JACOBSON & MARION JACOBSON**

Surveyed April 18, 1964, by R. Jackson.....