


T. 31 N. R. 33 E. 1/4 11

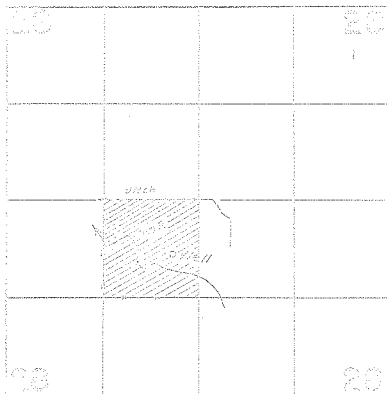

FINAL PROOF SURVEY
UNDER

Application No. 6-2480, Perm't No. 6-2258.
IN NAME OF

GEORGE E. PRESTON

Surveyed April 20, 1986, by B. Jackson.....