


# T.4N.R.28E.W.M.

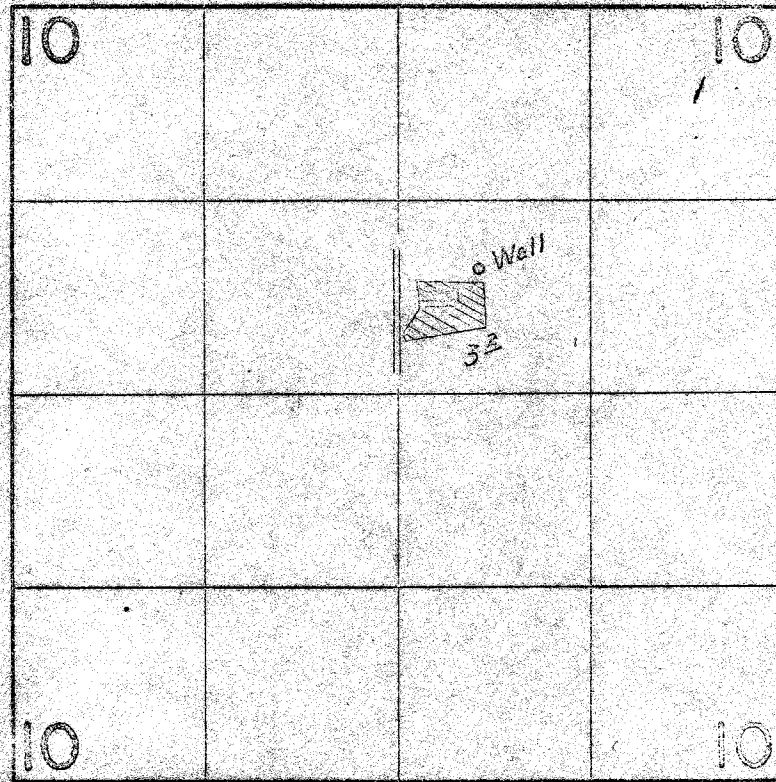

## FINAL PROOF SURVEY UNDER

Application No. G-2480. Permit No. G-2290.  
IN NAME OF

**HERMISTON UNIFIED SCHOOL DIST. # 8**

Surveyed April 16, 1964, by R. Jackson.....