


G 1712  
33378

# T.39S. R.10E.W.M.

Just River wells

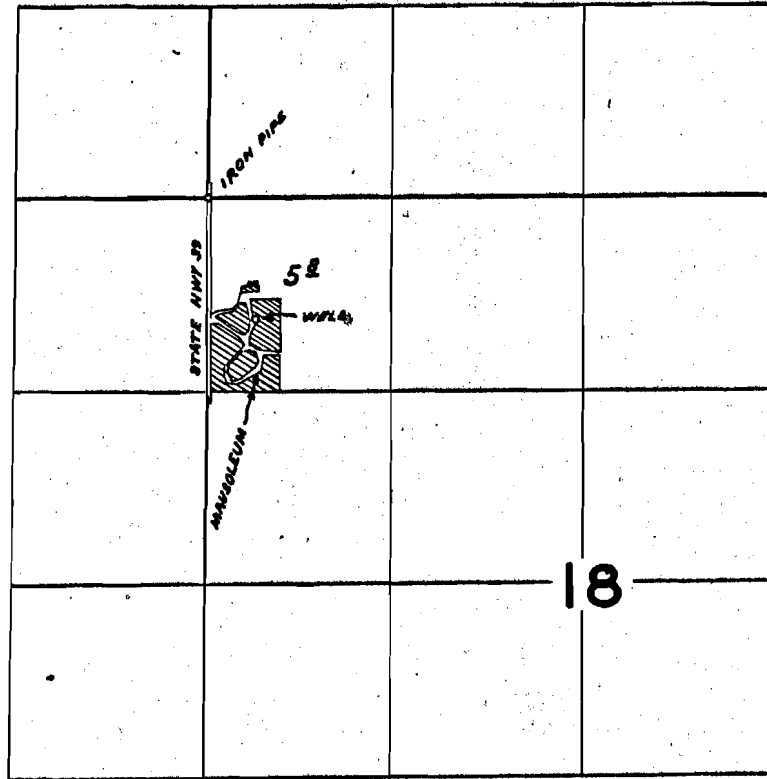

## FINAL PROOF SURVEY UNDER

Application No. G-1832 Permit No. G-1712  
IN NAME OF  
**ETERNAL HILLS  
MEMORIAL GARDENS, INC.**

Surveyed JUL. 22. 1964, by R. JACKSON