


T. 4N. R. 2W. W. M.

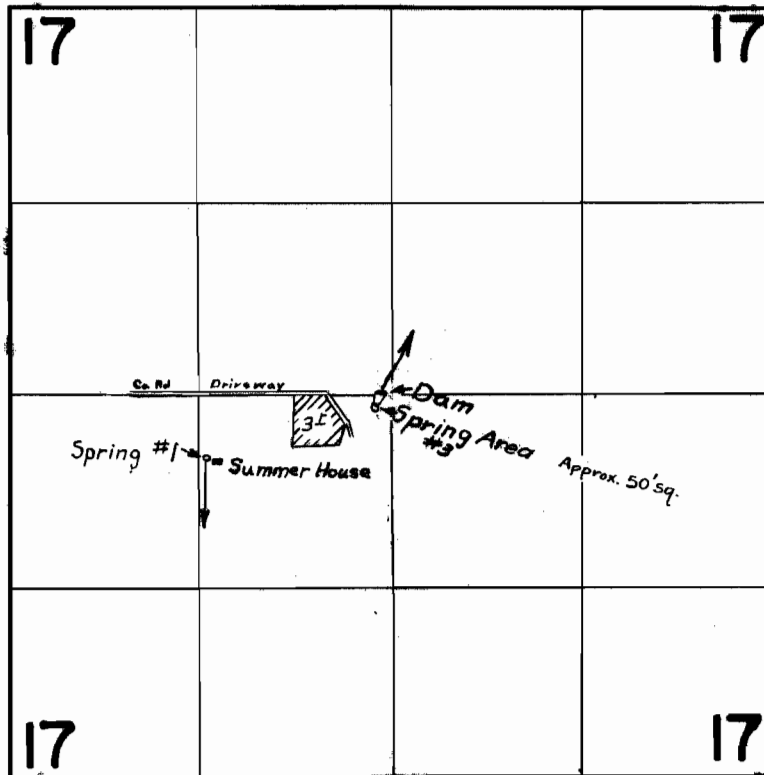

FINAL PROOF SURVEY
UNDER

Application No. 33122 Permit No. 26226
IN NAME OF

BURTON R. SMITH

Surveyed Oct. 5, 1964 by M. Bish