


T.18S. R.3W. W.M.

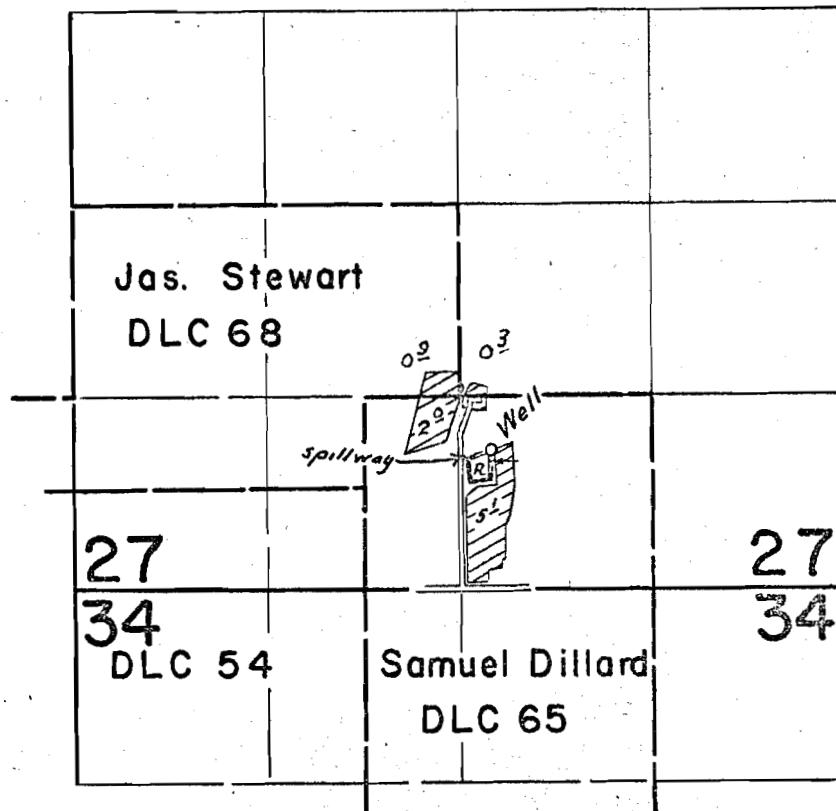

FINAL PROOF SURVEY
UNDER

G-2170 G-2001
34648 27251
Application No. R-34647. Permit No. R-2592...
IN NAME OF
ALMA WEBB

Surveyed July 6, 1964, by R. Jackson