


T.19S. R.1 W. W. M.

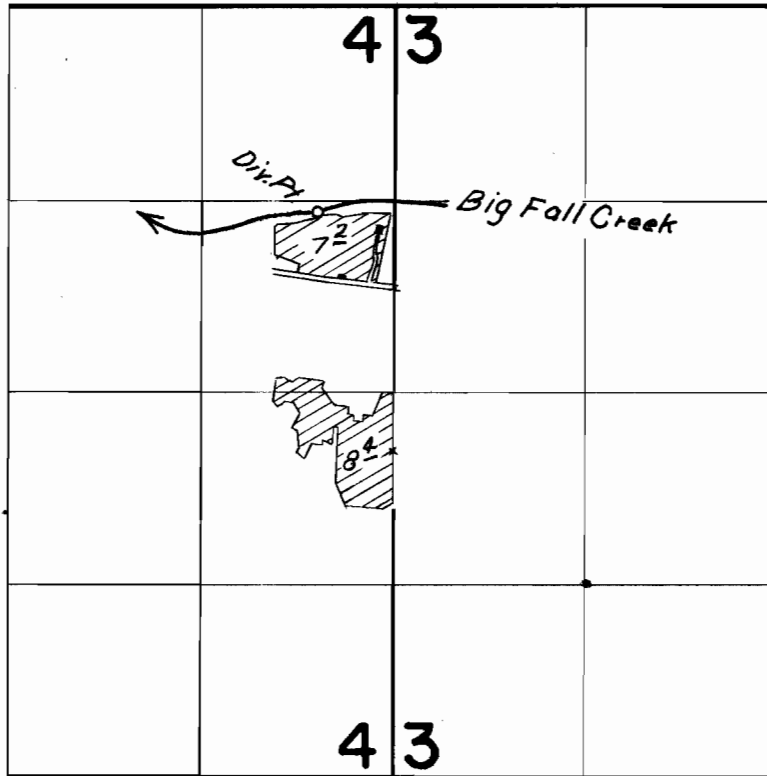

FINAL PROOF SURVEY
UNDER

Application No. 33939 Permit No. 26758
IN NAME OF
K. J. SIMPSON

Surveyed July 8, 1964, by R. Jackson