


T. 4S.R. 4W.W.M.

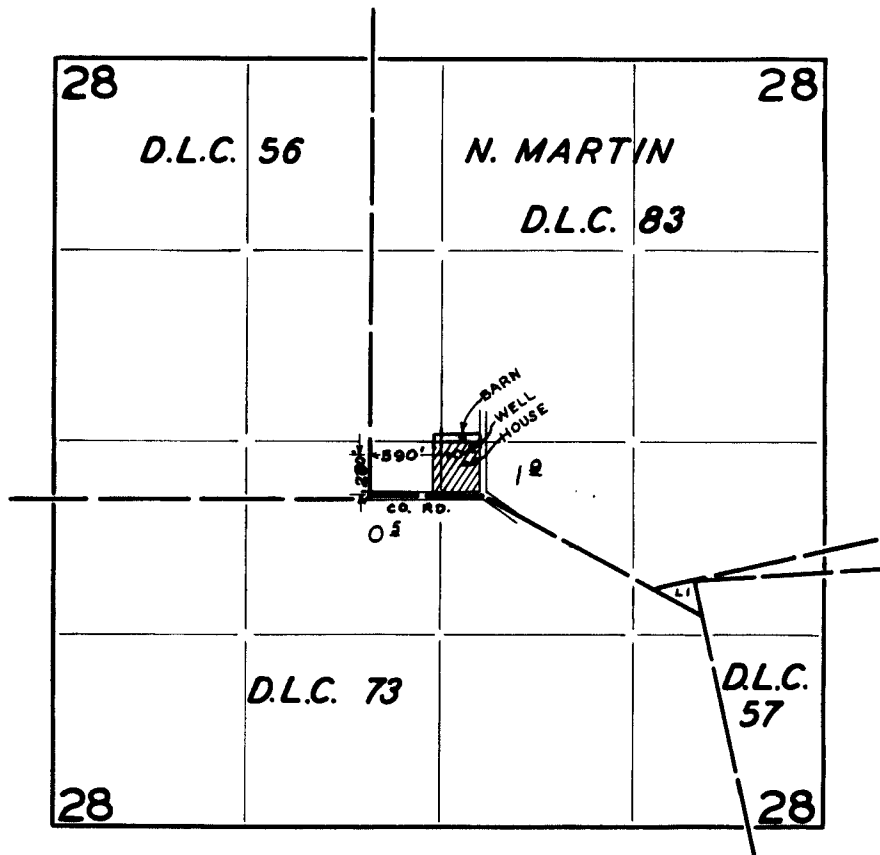

FINAL PROOF SURVEY
UNDER

Application No. G-2216 Permit No. G-2040
IN NAME OF

KEITH BERTLESTON

Surveyed Aug. 26 1964, by R. JACKSON