


# T.14 S.R.5 & 6 W.W.M.

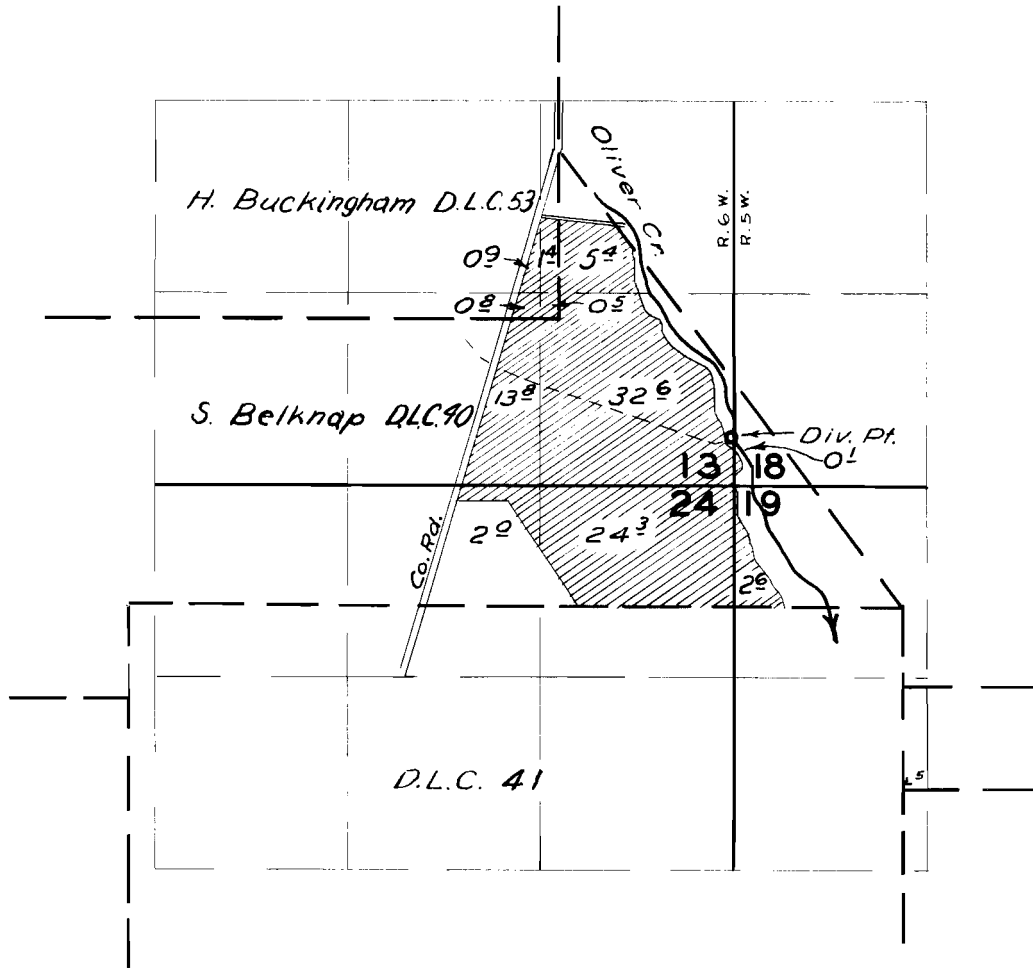

## FINAL PROOF SURVEY UNDER

Application No. 26595. Permit No. 20832.  
IN NAME OF

WINONA & HOWARD SRIGLEY

Surveyed 13 Mar. 1959, by *M. Rich*