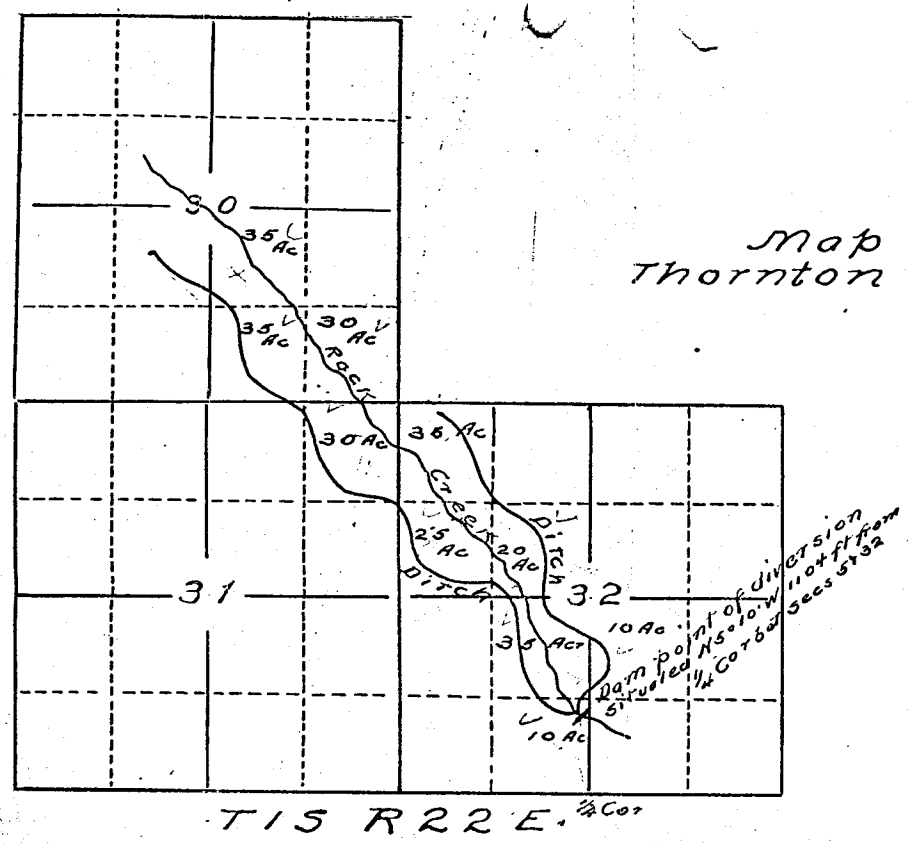

Map Of Thornton Ditch

Clb
note. dam is actually located in Sec 5, T. 1 S. R 22 E. within the NW¼ NE¼ this map is right

OF STATE
RECEIVED
JUN 10 1914.
LEM, OREGON,

Application No. 3699
Permit No. 2057

I A W Mohr of The Dalles Oregon. hereby certify that this map was made from notes taken during an actual survey made by me on the 19 Th day of March 1914 and that it correctly represents the work described in the accompanying application together with the location of streams and other ditches in the imediate vicinity and has written thereon the area in each smallest legal subdivision which it is proposed to irrigate

A W Mohr
Surveyor

Per 2057
3339