


T. 6 S. R. 1 W. W. M.

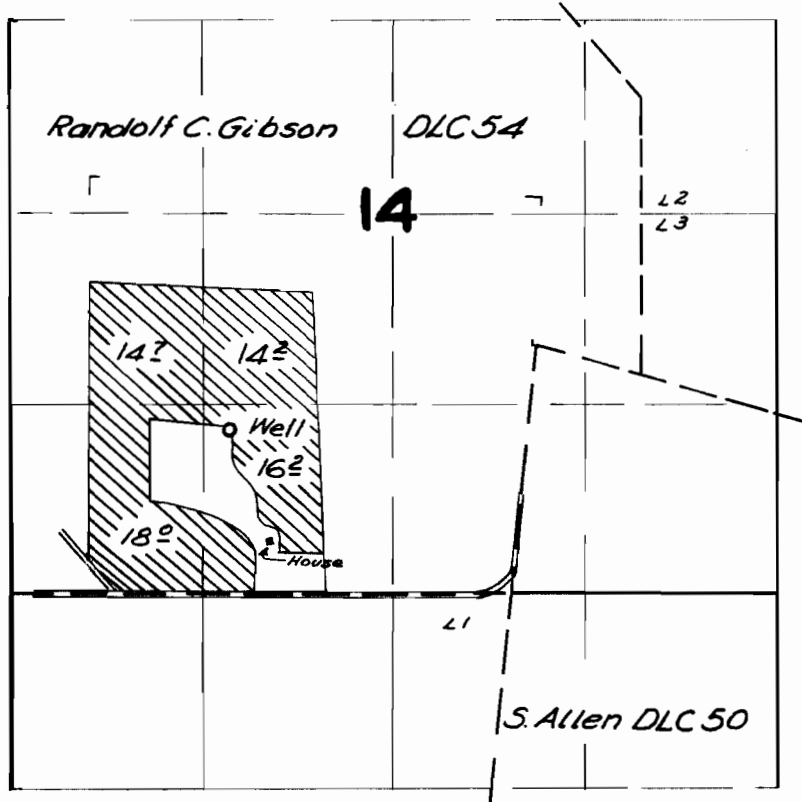

FINAL PROOF SURVEY UNDER

Application No. G-248 Permit No. G-198
IN NAME OF

FRANK X. AMAN

Surveyed April 23, 1958, by C.O. Bartels