


T.7&8S. R.2W.W.M.

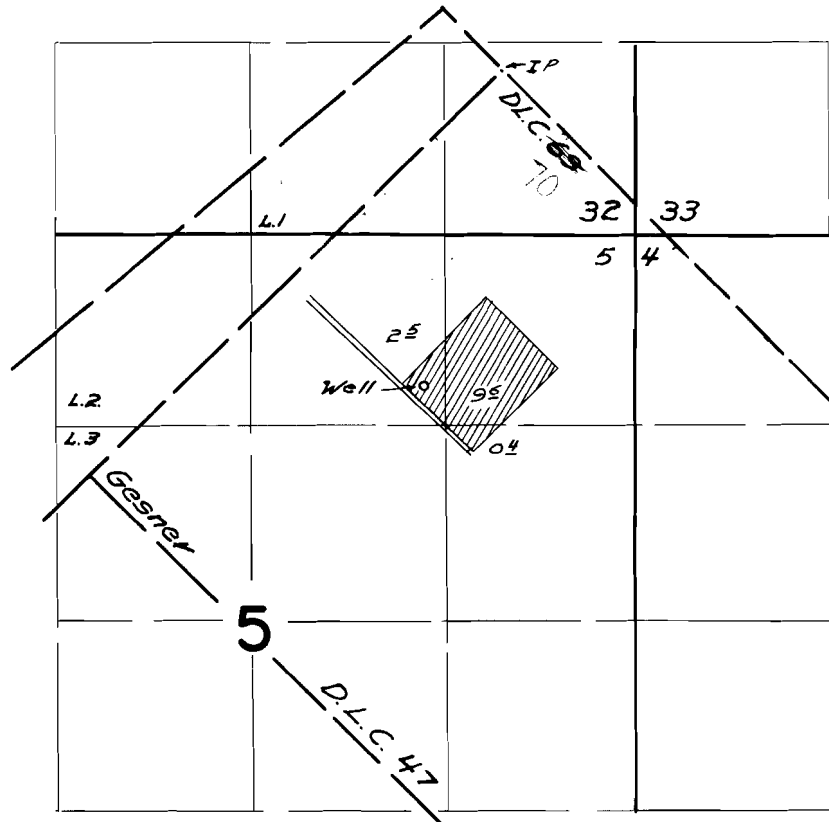

FINAL PROOF SURVEY UNDER

Application No. G-1998 Permit No. G-1836
IN NAME OF

J. L. Stanley

Surveyed Oct. 19 1966, by N. J. Ruppert