


T. 6 S. R. 1 W. W. M.

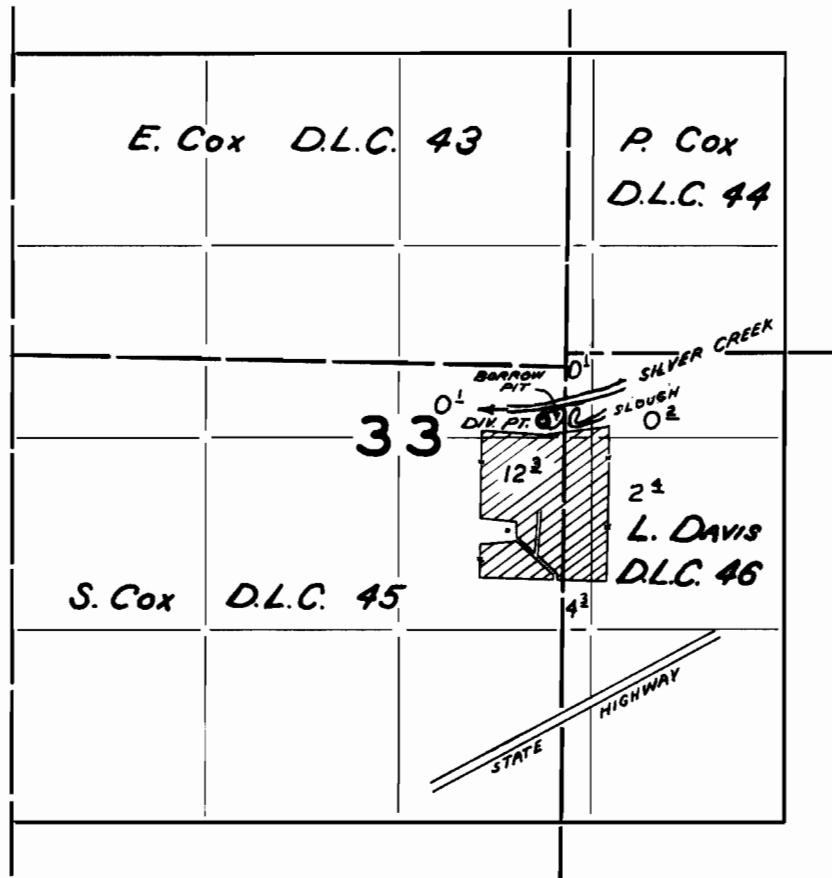

FINAL PROOF SURVEY
UNDER

Application No. 29202 Permit No. 18341
IN NAME OF

RUSSELL J. HARRIS

Surveyed AUG. 14, 1952, by H.L. COFFMAN