


T.6N.R.35&36E.W.M.

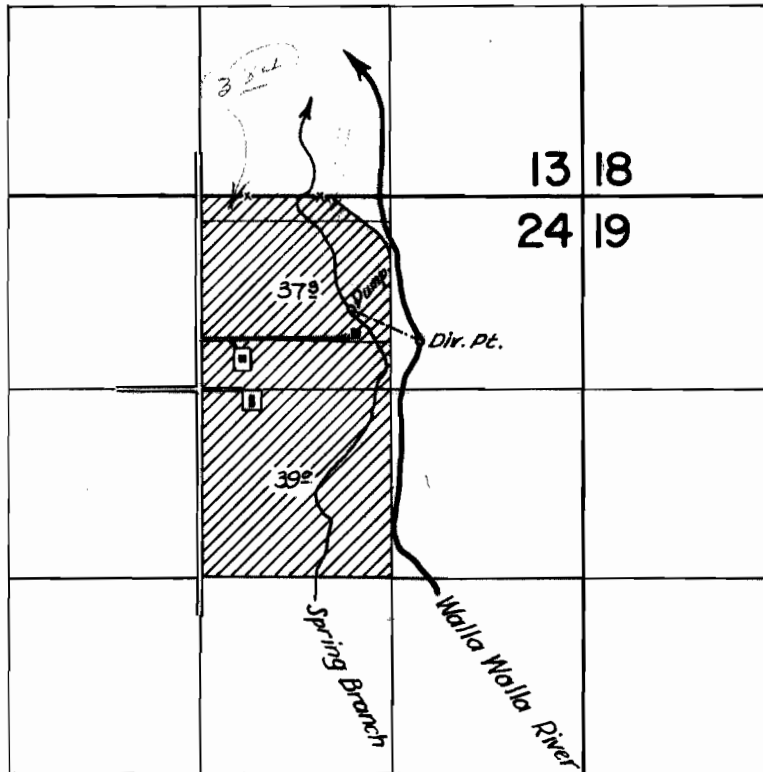

FINAL PROOF SURVEY
UNDER

Application No. 33897... Permit No. 26709.
IN NAME OF

HOWARD STEEN MURRAY

Surveyed April 30 1962, by *Alfred Cox*