


35
T.6N., R.36E., W.M.

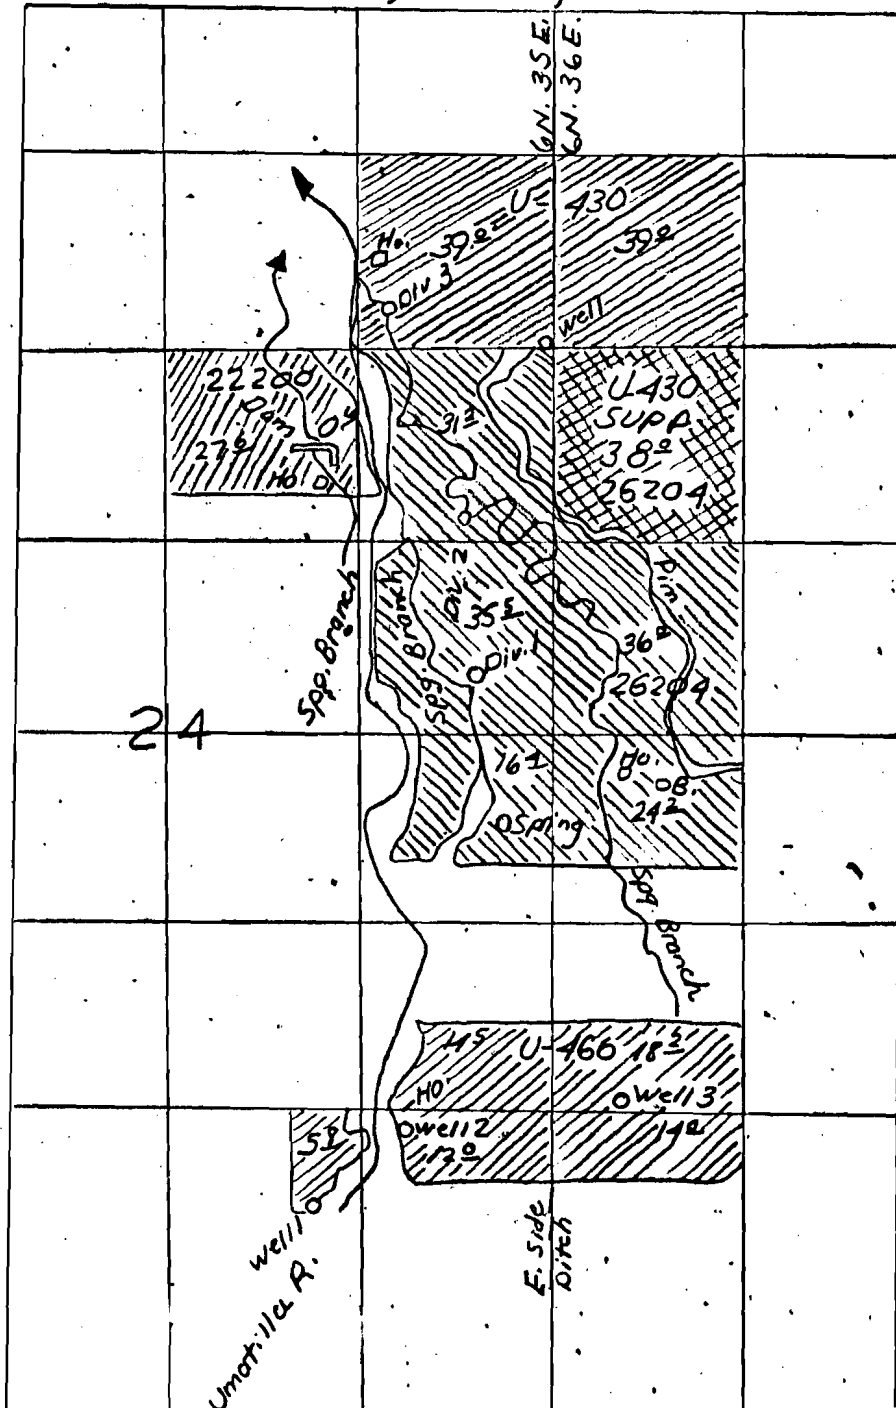

FINAL PROOF SURVEY

Vevo L. Heidenrich

Appl. No. U-466 Per. No. U-467

D. D. Nicholas

26204

20437

D. D. Nicholas

U-430

U-404

R. K. + G. K. Walter

22200

17482

copied in State Engineer's Office