


# T.8 S.R. 40 E. W.M.

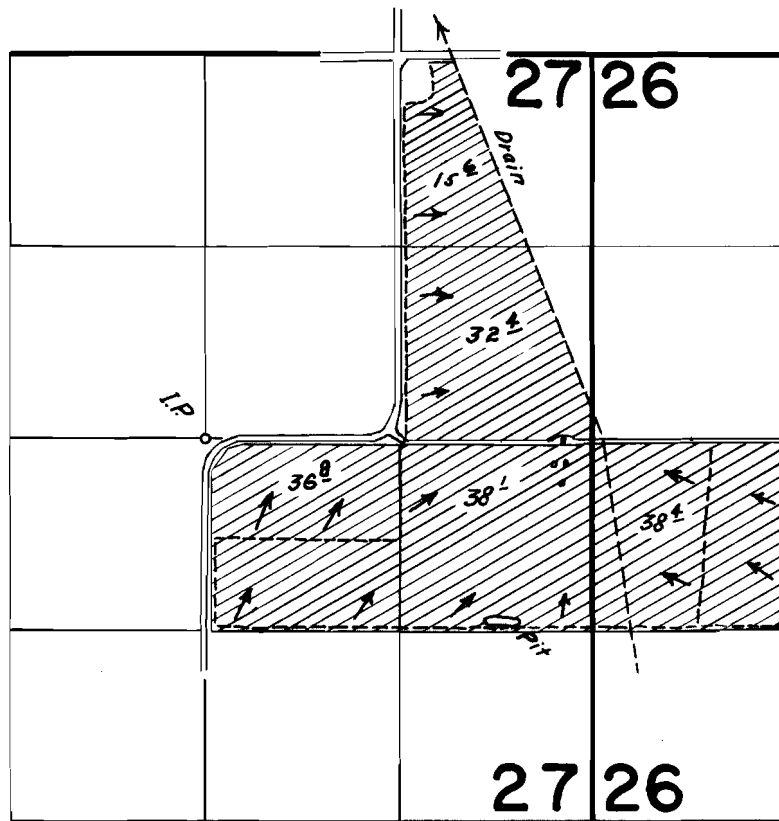

## FINAL PROOF SURVEY UNDER

Application No. G-1941... Permit No. G-1784...  
IN NAME OF

CLYDE WARD

Surveyed Nov. 11, 1964, by R. Jackson